


Section 35 Township 11 Range 15-W

Well No. #1 Eulert

Company Anschutz Drig
Fairport Pool

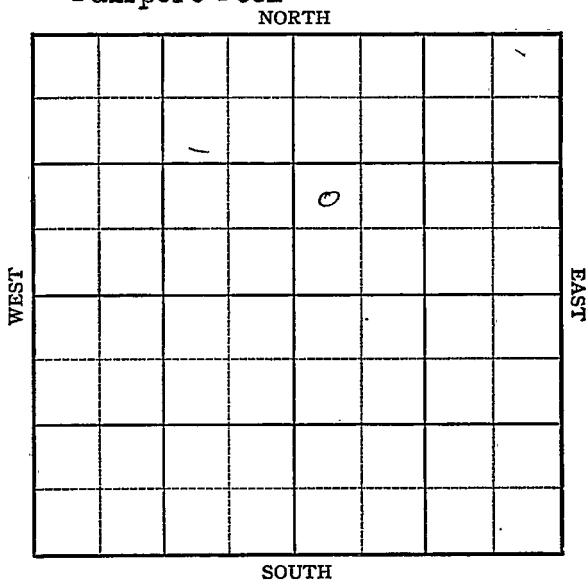

Sec. 35 Twp. 11 R. 15W

Well No. #1 Eulert Farm

Anschutz Drlg. Company

Anschutz Drlg. Contractor

Fairport Pool

Ft. from N. Line

990'


Ft. from S. Line

Ft. from E. Line

330'

Ft. from W. Line

NW SW NE

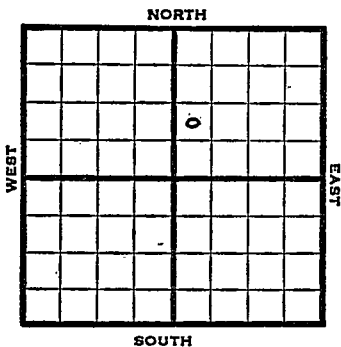

1949 Elev. 1836' REPORT

11/9 8" @ 117'
Drlg. 1985'
11/16 Topeka 2688'
Lansing 2992'
Arb. 3303-07'
TD 3307'
5" @ 3304'
11/23 TD 3311-
1000 acid
Swb 3½ bbls oil PH 6 hrs.
11/29 "
12/7 "
12/14 Arb 3303'
5" @ 3304'
1500 Acid
Pump 99 oil Pot.
Gr. 38°
TD 3311'

COMPLETED

Map No. _____ Sec. 35 Twp. 11 R. 15W

Well No. 1 Eulert

Anschutz Drlg.

Company

Anschutz

Contractor

NW SWNE

FIRST REPORT
SECTION PLAT

_____ Ft. from N. Line

990 Ft. from S. Line

_____ Ft. from E. Line

330 Ft. from W. Line

Russell County

Location _____

Rig up _____

Drilling and Remarks:

8" @ 117

drlg. 1985

RECORD

Cased _____ in., _____ ft.

Sand _____

Gas _____

Oil _____

Total Depth _____

PRODUCTION

1st 24 hrs. Nat. _____

1st 24 hrs. after shot _____

Gas _____ Cu. Ft.

Dry Hole _____

Abandoned _____

Date

NOV 9 1949 19

S. J. LEWIS

Scout

Kansas

Map No. _____ Sec. 35 Twp. 11 R. 15WWell No. 1 Eulert "B"

Anschutz Drlg. _____ Company _____

COMPLETE

Contractor

NW SW NE

E. J. 1836.
SECTION PLAT

_____ Ft. from N. Line

990 Ft. from S. Line

_____ Ft. from E. Line

330 Ft. from W. Line

		o	
		i	

Russell County

Location _____

Rig up _____

Drilling and Remarks:


RECORD

Cased _____ in., _____ ft.

Sand _____

Gas _____

Oil _____

Total Depth 3311

PRODUCTION

1st 24 hrs. Nat. _____

1st 24 hrs. after shot _____

Gas _____ Cu. Ft.

Dry Hole _____

Abandoned _____

Date

DEC 14 1949 19S. J. LEWIS Scout