FORM 51 25M 3-49 PETROL

KANSAS


Russell

Section 35 Township 11 Range 15-W

Well No. #2 Eulert "A"

Company Atlantic

Fairport Pool

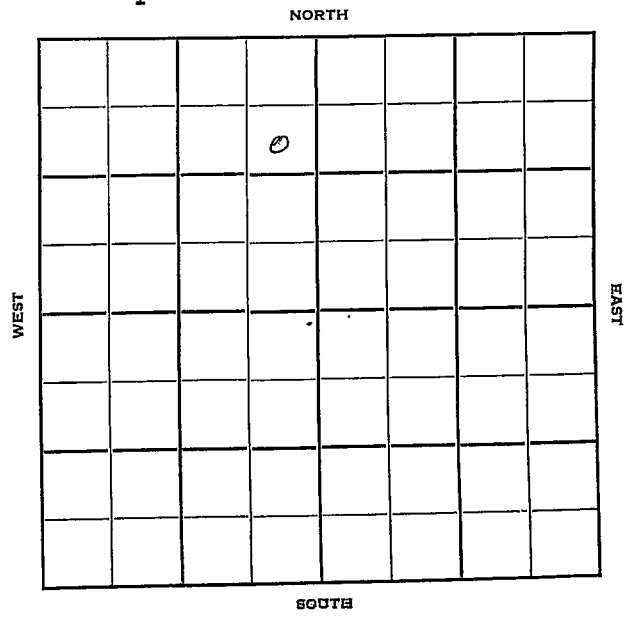

FORM 252-A
5M 10-48 PETROL

Russell KANSAS

Sec. 35 Twp. 11 R. 15W

Well No. #2 Eulert "A" Farm

Atlantic Company
(Anschutz Drlg., Contr.)

Fairport Pool


990' Ft. from N. Line

Ft. from S. Line

330' Ft. from E. Line

Ft. from W. Line

SE NE NW

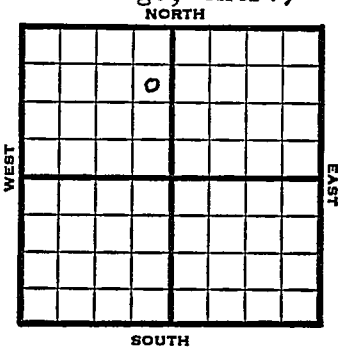

1949	Elev. 1834' REPORT
11/30	RUR
12/7	Drlg 2730' 8"@ 227'
12/14	Arb. 3344' TD 3366' ABANDONED

Form 26 200 Bks. 6-42 Petrol

Kansas

Fairport Pool

Map No. ____ Sec. 35 Twp. 11 R. 15W

Well No. 2 Eulert "A"

Atlantic Company

Anschutz Drlg. Contractor

SE NE NW

990 Ft. from N. Line


____ Ft. from S. Line

330 Ft. from E. Line

____ Ft. from W. Line

FIRST REPORT

SECTION PLAT

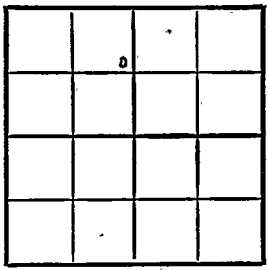

Russell County

Location ____

Rig up ____

Drilling and Remarks:

R U R

RECORD

Cased ____ in., ____ ft.

Sand ____

Gas ____

Oil ____

Total Depth ____

PRODUCTION

1st 24 hrs. Nat. ____

1st 24 hrs. after shot ____

Gas ____ Cu. Ft.

Dry Hole ____

Abandoned ____

Date

NOV 30 1949 19

S. J. LEWIS Scout

Form 26 200 Bks. 6-49 Petrol

Fairport Pool

Kansas

Map No. ____ Sec. 35 Twp. 11 R. 15W

Well No. 2 Eulert "A"

Atlantic

Company


ABANDONED

Contractor

SE NE NW

E/1854

SECTION PLAT

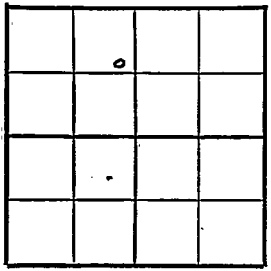

990 Ft. from N. Line

____ Ft. from S. Line

330 Ft. from E. Line

____ Ft. from W. Line

Russell County

Location ____

Rig up ____

Drilling and Remarks:

CR 43344

RECORD

Cased ____ in., ____ ft.

Sand ____

Gas ____

Oil ____

Total Depth 3366.

PRODUCTION

1st 24 hrs. Nat. ____

1st 24 hrs. after shot ____

Gas ____ Cu. Ft.

Dry Hole ____

Abandoned ____

Date

DEC 14 1949 19

S. J. LEWIS Scout