


Section 35 Township 11 Range 15W

Well No. #2 Eulert "B"

Company Atlantic

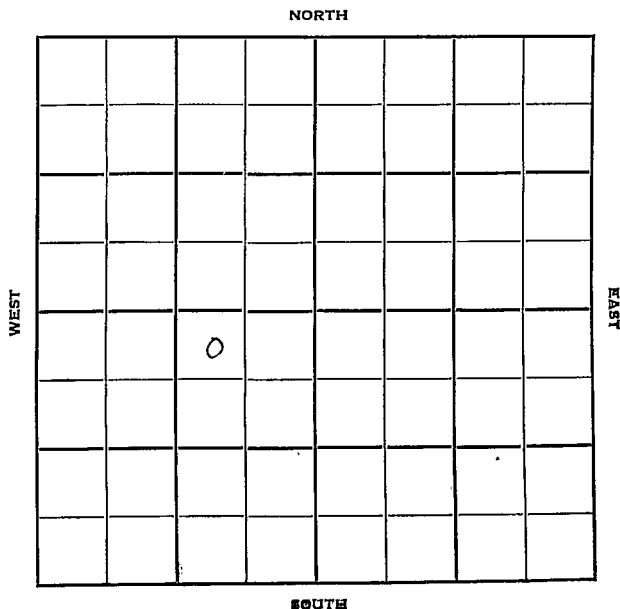

KANSAS

Russell

Sec. 35 Twp. 11 R. 15-W ✓

Well No. #2 Eulert "B" Farm

Atlantic

Company

Anchutz Drlg
Fairport Pool

330

Ft. from N. Line


Ft. from S. Line

990

Ft. from E. Line

Ft. from W. Line

NW NE SW

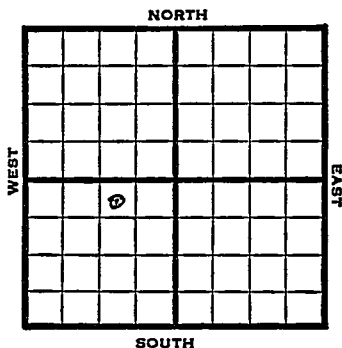

1950

Elev 1769'

R E P O R T

2/22

RUR

5/3

TD 3234'

8"@ 246'

Lans 2917'

Arb. 3215'

5"@ 3216'

Perf 32/3218-22

233 BOPD

Comp

COMPLETED

Map No. _____ Sec. 35 Twp. 11 R. 15WWell No. 2 Eulert "B"

_____ Atlantic _____ Company

_____ Anchutz Drlg. _____ Contractor

NW NE SW


330 Ft. from N. Line

_____ Ft. from S. Line

990 Ft. from E. Line

_____ Ft. from W. Line

SECTION PLAT

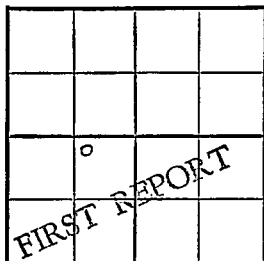

Russell County

Location _____

Rig up _____

Drilling and Remarks:

R U R

RECORD

Cased _____ in., _____ ft.

Sand _____

Gas _____

Oil _____

Total Depth _____

PRODUCTION

1st 24 hrs. Nat. _____

1st 24 hrs. after shot _____

Gas _____ Cu. Ft.

Dry Hole _____

Abandoned _____

Date

FEB 22 1950 19J. E. TYRA Scout

Kansas

Fairport Pool

Map No. _____ Sec. 35 Twp. 11 R. 15WWell No. 2 Eulert "B"

_____ Atlantic _____ Company

_____ Contractor

NW NE SW

E. 1769
SECTION PLAT330 Ft. from N. Line

_____ Ft. from S. Line

990 Ft. from E. Line

_____ Ft. from W. Line

	COMPLETE		
	o		

Russell County

Location _____

Rig up _____

Drilling and Remarks:

*8" @ 246**Lanz 2917**arb 3213**5" @ 3216**perf 32/3218-22**233 BOPD*

RECORD

Cased _____ in., _____ ft.

Sand _____

Gas _____

Oil _____

Total Depth *3234*

PRODUCTION

1st 24 hrs. Nat. _____

1st 24 hrs. after shot _____

Gas _____ Cu. Ft.

Dry Hole _____

Abandoned _____

Date

MAY 3 1950 19

J. E. TYRA Scout