


Section 35 Township 11 Range 15W

Well No. #2 Eluert "B"

Company Anschutz Drlg.

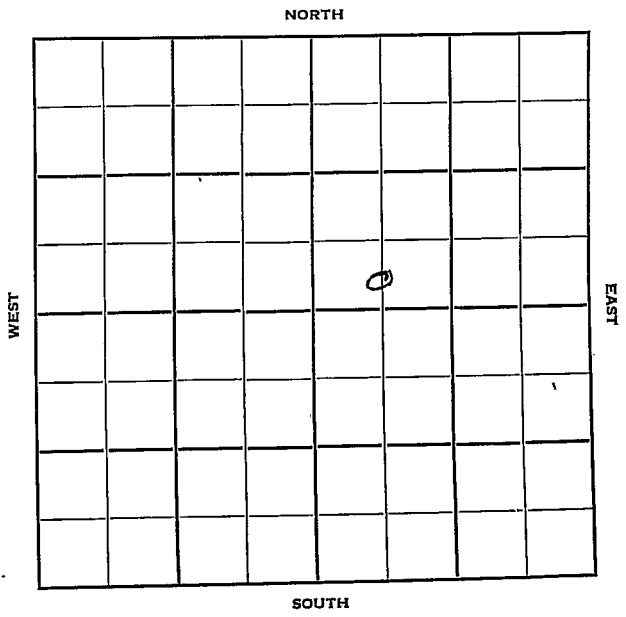

Russell

KANSAS ✓

Sec. 35 Twp. 11 R. 15W

Well No. #2 Eluert "B" Farm

Anschutz Drlg. Company


Fairport Pool (Stearns Drlg., ~~Contr.~~)

_____ Ft. from N. Line

330' Ft. from S. Line

_____ Ft. from E. Line

660' Ft. from W. Line

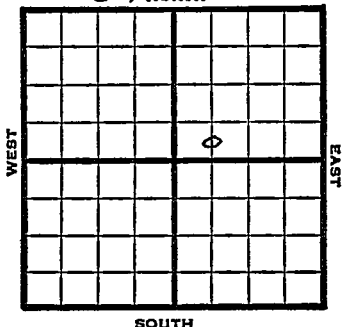

C S L SW NE

SOUTH

1949

Elev' 1821' REPORT

12/28

Location

1950

2/15

TD 3291'
8"@ 894'
5"@ 3283'
P 53 BOPD
Comp

COMPLETED

Map No. _____ Sec. 35 Twp. 11 R. 15W

Well No. 2. Eluert "B"

_____ Anschutz Drlg. _____ Company

_____ Stearns Drlg. _____ Contractor

C S L SW NE

FIRST REPORT
SECTION PLAT

_____ Ft. from N. Line

330

_____ Ft. from S. Line

_____ Ft. from E. Line

660

_____ Ft. from W. Line

		o	

Russell County

Location X

Rig up _____

Drilling and Remarks:

...

RECORD

Cased _____ in., _____ ft.

Sand _____

Gas _____

Oil _____

Total Depth _____

PRODUCTION

1st 24 hrs. Nat. _____

1st 24 hrs. after shot _____

Gas _____ Cu. Ft.

Dry Hole _____

Abandoned _____

Date

DEC 28 1949

19

S. J. LEWIS

Scout

Kansas

Map No. _____ Sec. 35 Twp. 11 R. 15W

Well No. 2 Eulert "B"

Anschutz _____ Company

Contractor

C S L SW NE

E. 1821
SECTION PLAT

_____ Ft. from N. Line

330 Ft. from S. Line

_____ Ft. from E. Line

660 Ft. from W. Line

Russell County

COMPLETE			
		o	

Location _____

Rig up _____

Drilling and Remarks:

8" @ 894

5" @ 3283

p 53 BOPD

f

RECORD

Cased _____ in., _____ ft.

Sand _____

Gas _____

Oil _____

Total Depth 3291

PRODUCTION

1st 24 hrs. Nat. _____

1st 24 hrs. after shot _____

Gas _____ Cu. Ft.

Dry Hole _____

Abandoned _____

Date

FEB 15 1950
19

J. E. TYRA

Scout