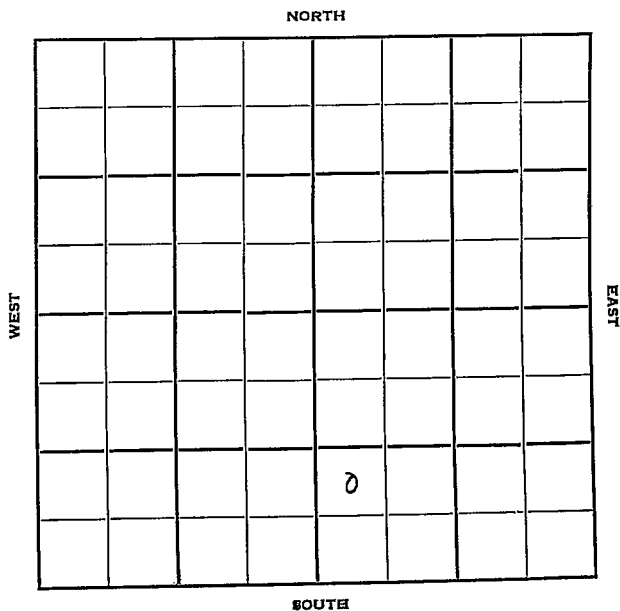


Section 35 Township 11 Range 15WWell No. #2 Eulert "A"Company Anschutz Drlg.

Russell KANSAS ✓

Sec. 35 Twp. 11 R. 15W

Well No. #2 Eulert "A" Farm

Anschutz Drlg.

Fairport (Anschutz Drlg, Contr.) Company
Drlg.


Ft. from N. Line

990' Ft. from S. Line

Ft. from E. Line

330' Ft. from W. Line

NW SW SE

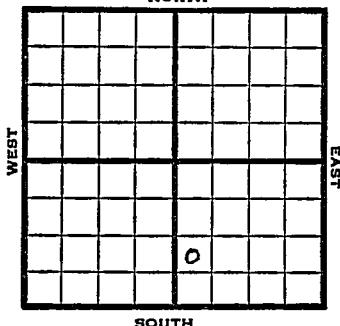

1949 Elev. 1834' REPORT

11/23 8" @ 116'

Anhy 890'

Drlg. 2050'

11/29 Topeka 2678'

Lansing 2979'

Arb. 3276'

TD 3280

5" @ 3277'

12/7 TD 3284'

1000 acid

Swb 50 bbls oil PH

12/14 Arb 3276'

5" @ 3277'

Acid 1000

Echo Pot. & 3000 oil

Grav. 38°

TD 3284'

COMPLETED

Map No. _____ Sec. 35 Twp. 11 R. 15W

Well No. 2 Eulert "A"

Anschutz Drlg. _____ Company

Anschutz Drlg. _____ Contractor

NW SW SE


**FIRST REPORT
SECTION PLAT**

_____ Ft. from N. Line

990 Ft. from S. Line

_____ Ft. from E. Line

330 Ft. from W. Line

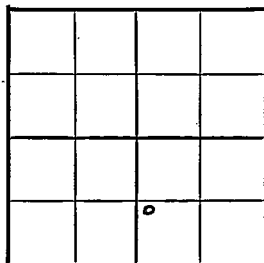

Russell County

Location _____

Rig up _____

Drilling and Remarks:

8" @ 116

Anhy 890

drlg. 2050

RECORD

Cased _____ in., _____ ft.

Sand _____

Gas _____

Oil _____

Total Depth _____

PRODUCTION

1st 24 hrs. Nat. _____

1st 24 hrs. after shot _____

Gas _____ Cu. Ft.

Dry Hole _____

Abandoned _____

Date

NOV 23 1949

19

S. J. LEWIS

Scout

Kansas

Map No. _____ Sec. 35 Twp. 11 R. 15W

Well No. 2 Eulert "A"

Anschutz Drlg. _____ Company

COMPLETE

Contractor

NW SW SE

E 11834
SECTION PLAT

		0	

_____ Ft. from N. Line

990 _____ Ft. from S. Line

_____ Ft. from E. Line

330 _____ Ft. from W. Line

Russell County

Location _____

Rig up _____

Drilling and Remarks:

Per 43276

5" C 3277

10000 cu ft

Echo Per 3000 cu ft

250 cu ft

RECORD

Cased _____ in., _____ ft.

Sand _____

Gas _____

Oil _____

Total Depth 3274

PRODUCTION

1st 24 hrs. Nat. _____

1st 24 hrs. after shot _____

Gas _____ Cu. Ft.

Dry Hole _____

Abandoned _____

Date

DEC 14 1949

S. J. LEWIS

Scout