


Section 35 Township 11 Range 15-W

Well No. #3 Eulert "B"

Company Atlantic

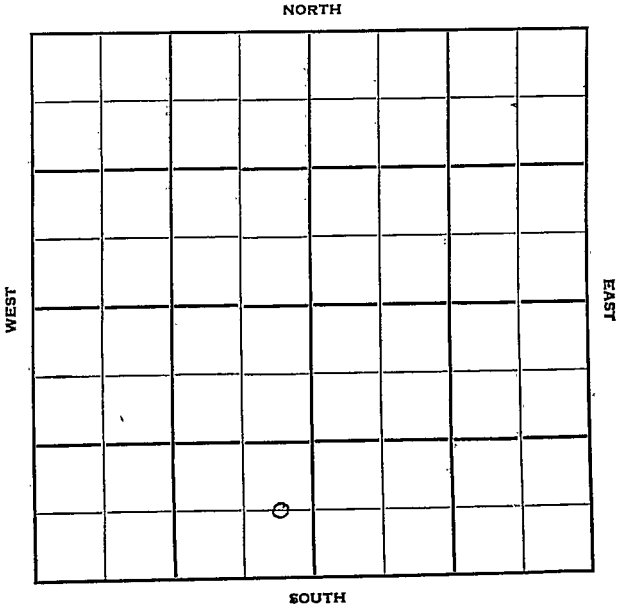

Russell

KANSAS

Sec. 35 Twp. 11 R. 15W

Well No. #3
#1
#4 Eulert "B" Farm

Atlantic

Company

Contractor


_____ Ft. from N. Line

660' Ft. from S. Line

330' Ft. from E. Line

_____ Ft. from W. Line

C E L SE SW

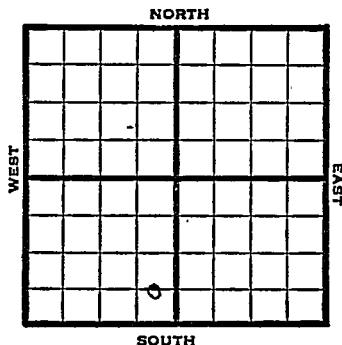

1950

Elev 1797

REPORT

6/28

Location

8/16

8 5/8" @ 246

Lans 2949

Arb 3248-51

5" @ 3250

TD 3263

1000 A

S/10 boph

Comp 244 bopd

Completed

COMPLETED

Your first report shows #4

You complete as #3

Advise

Sam

#3 is correct. First report
must have been a typing error.

AUG 23 1950

Scout Cards	70
Land Small Map	
Land Wall Map	3
Tracings	
France Map	
Pierce Map	
Misc	

Prig. Data