


Section 35 Township 11 Range 15W

Well No. #5 Eulert "B"

Company Atlantic

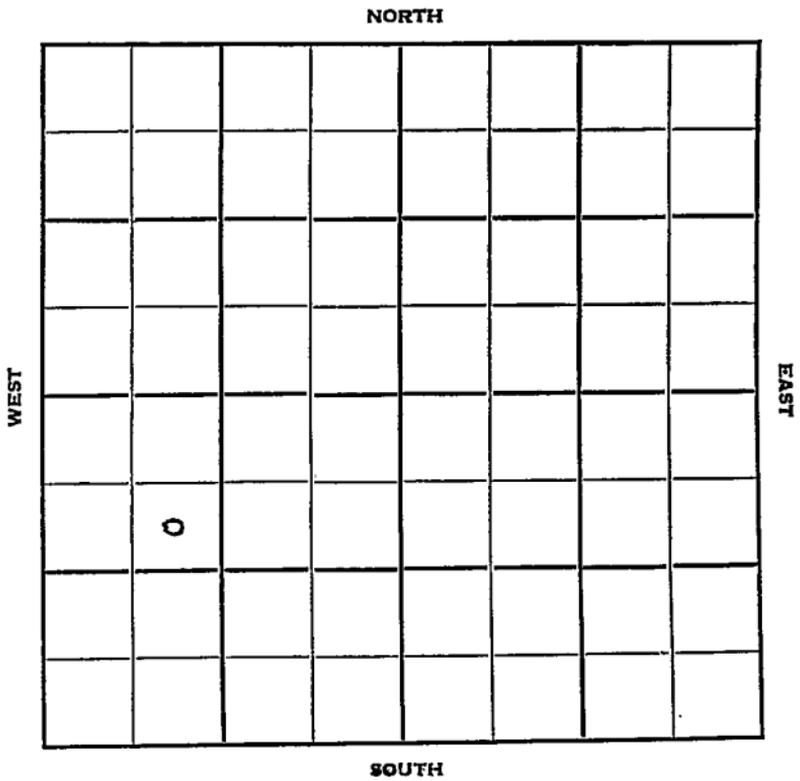

Russell KANSAS

Sec. 35 Twp. 11 R. 15 W ✓

Well No. # 5 Eulert "B" Farm

Atlantic Company

Anschutz Drlg. Contractor

Eulert Pool


990 Ft. from N. Line

_____ Ft. from S. Line

_____ Ft. from E. Line

990 Ft. from W. Line

SE NW SW

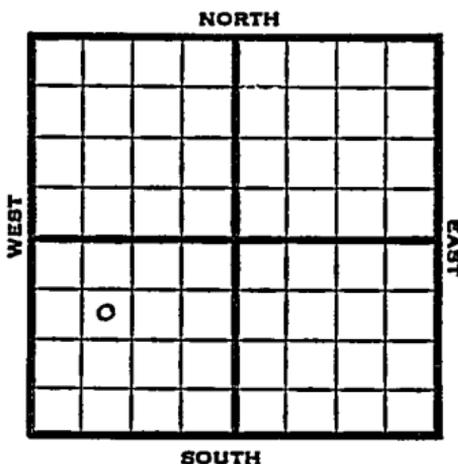

1951

Elev. 1812' REPORT

4/11

Location

6/13

Spud 4-17-51

Oil well TD 3294' 8" @ 243'

Heeb 2907' Tor 2927' Lans 2960'

Arb. 3288'

DST 3289-94 open 1 hr. rec 25' free oil, 10' OCM

TD 3294 5" @ 3289 250 A

40 GOPH 1000 A S/7 BOPH

Comp. 202 BOPD

COMPLETED

