

KANSAS

FORM 51 5M 10-41 PETROL


Ellis

Section 35 Township 11 Range 18-W

Well No. #2 Gunther

Company Imo Oil & Gas

NORTH Koblitz Pool

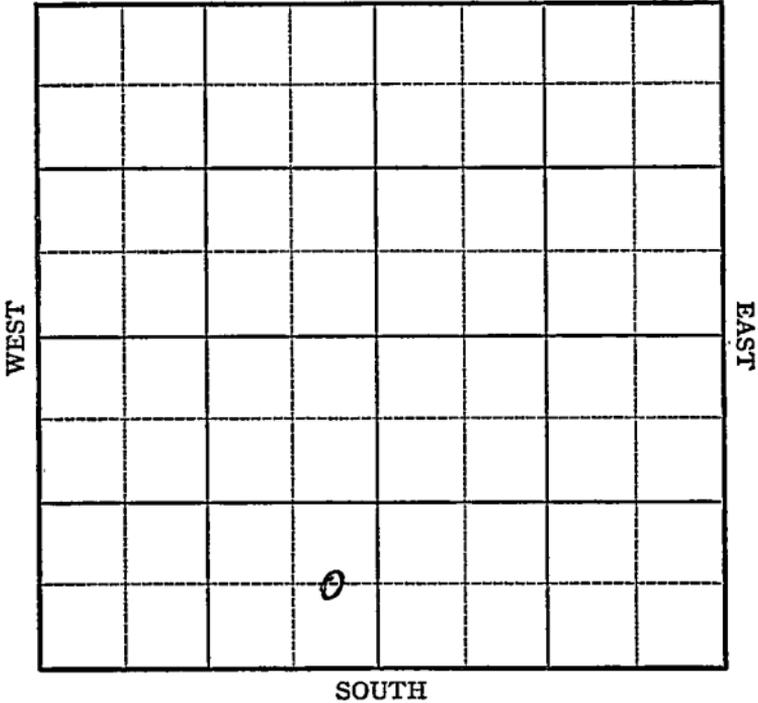

SOUTH

Sec. 35 Twp. 11 R. 18-W

Well No. #2 Gunther Farm

Imo Oil & Gas Company

(Koblitz)


_____ Ft. from N. Line

660 Ft. from S. Line

330 Ft. from E. Line

_____ Ft. from W. Line

Elev. 2111

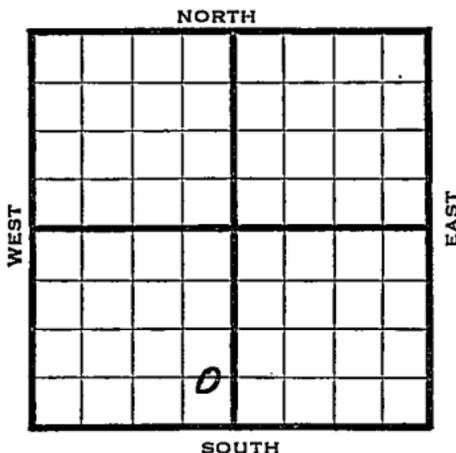

1942

REPORT

7/8

13" - 65' 8" - 1365'
Anhy. 1360' Topeka 3095'
Drlg. 3265'

7/15

Cong. 3654'
T.D. 3672' in Cong.

ABANDONED

Ellis

Map No. 71 Sec. 35 Twp. 11 R. 18WWell No. 2 Günther

Imo Oil & Gas

Company

FIRST REPORT

Contractor

C E L S E S W

SECTION PLAT

_____ Ft. from N. Line

660 Ft. from S. Line330 Ft. from E. Line

_____ Ft. from W. Line

KOBLOITZ POOL

Location _____

Rig up _____

Drilling and Remarks:

13" - 65'

8" - 1365'

Anhy. 1360'

Topeka 3095'

Drlg. 3265'

RECORD

Cased _____ in., _____ ft.

Sand _____

Gas _____

Oil _____

Total Depth _____

PRODUCTION

1st 24 hrs. Nat. _____

1st 24 hrs. after shot _____

Gas _____ Cu. Ft.

Dry Hole _____

Abandoned _____

Date

JUL 8 1942 19

S. J. LEWIS

Scout

Ellis

KANSAS

Map No. 71 Sec. 35 Twp. 11 R. 18W

Well No. 2 Gunther

Imo Oil & Gas Company

ABANDONED

Contractor

C E L S E S W

SECTION PLAT

_____ Ft. from N. Line

660 Ft. from S. Line

330 Ft. from E. Line

_____ Ft. from W. Line

KOBLITZ POOL

Location _____

Rig up _____

Drilling and Remarks:

Cong 3654
3672 in Cong.

RECORD

Cased _____ in., _____ ft.

Sand _____

Gas _____

Oil _____

Total Depth 3672

PRODUCTION

1st 24 hrs. Nat. _____

1st 24 hrs. after shot _____

Gas _____ Cu. Ft.

Dry Hole _____

Abandoned _____

Date

JUL 15 1942 19

S. I. LEWIS Scout