

KANSAS

Ellis


FORM 51 5M 4-41 PETROL

Section 35 Township 11 Range 18-W

Well No. 1 Gunther

Company Imo Oil & Gas

NORTH Bemis pool

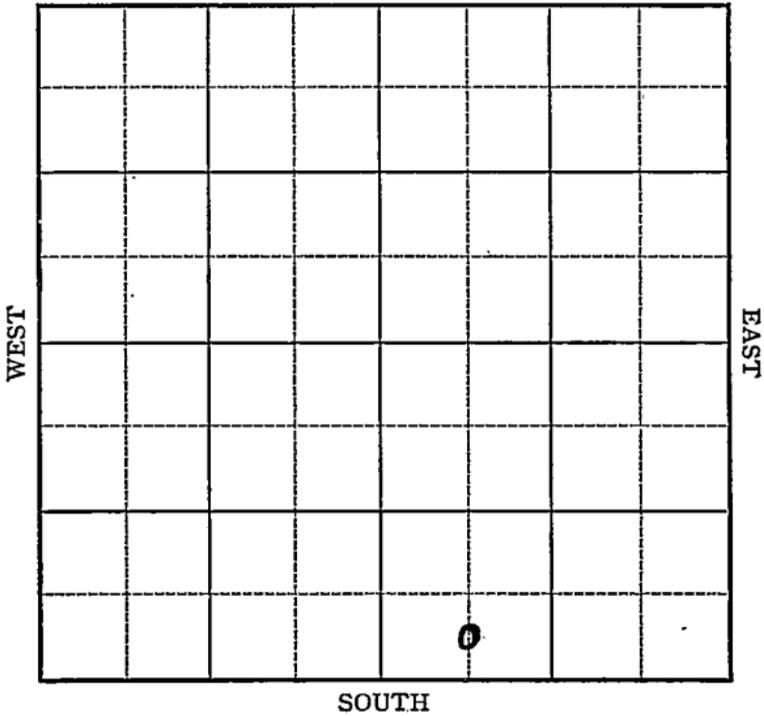

15

Sec. 35 Twp. 11 R. 18-W

Well No. #1 Gunther Farm
Imo Oil & Gas Company


(Benia)

_____ Ft. from N. Line

330 Ft. from S. Line

_____ Ft. from E. Line

660 Ft. from W. Line

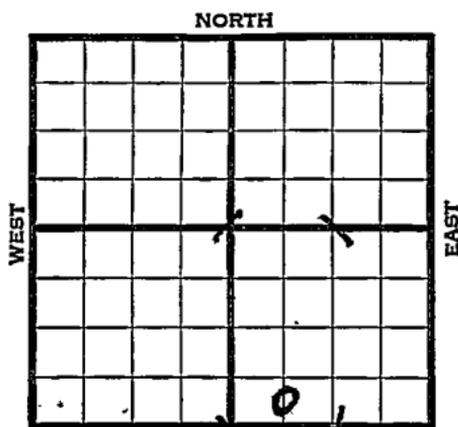

Elev. 2045

1941	REPORT
8/27	Derrick.
9/4	Anhy 1300' 8" - 1300'
	Drlg. 2000'
9/11	Lans. 3319' Drlg. 3422'
9/18	Arb. 3580-81' T.D. 5" - 3580'
	RUST.
9/25	T.D. 3585' 3000 acid.
10/2	" " " "
10/9	" " " "
10/16	T.D. 3588' Testing.
10/23	Pump 400 in 24 hours.
10/30	" " " "
11/5	Arb. 3580'
	5" - 3580'
	T.D. 3588'
	3000 acid.
	Potential 311 bbls., pump.
	23. Gravity
	COMPLETED

Map No. _____ Sec. 35 Twp. 11 R. 18W

Well No. 1 Gunther

Imo Oil & Gas Company

~~FIRST REPORT~~ Contractor

SECTION PLAT


C S L SW SE

_____ Ft. from N. Line

330 Ft. from S. Line

_____ Ft. from E. Line

660 Ft. from W. Line

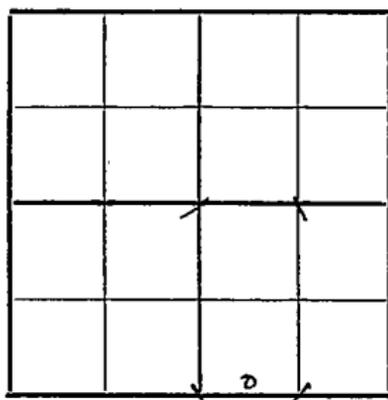

BEMIS POOL

Location _____

Rig up _____

Drilling and Remarks:

Derrick

RECORD

Cased _____ in., _____ ft.

Sand _____

Gas _____

Oil _____

Total Depth _____

PRODUCTION

1st 24 hrs. Nat. _____

1st 24 hrs. after shot _____

Gas _____ Cu. Ft.

Dry Hole _____

Abandoned _____

Date

AUG 27 1941

19

S. J. LEWIS

Scout

Map No. K-71 Sec. 35 Twp. 11 R. 18WWell No. 1 GuntherImo Oil & Gas CompanyCOMPLETED Contractor

C SL SW SE

SECTION PLAT

 Ft. from N. Line330 Ft. from S. Line Ft. from E. Line660 Ft. from W. Line

WALTERS POOL

Location Rig up

Drilling and Remarks:

ce x 3580
5" @ 3580
3000 @ oil
Pump 311 P & X

230 cu.

RECORD

Cased in., ft.Sand Gas Oil Total Depth 3588

PRODUCTION

1st 24 hrs. Nat. 1st 24 hrs. after shot Gas Cu. Ft.Dry Hole Abandoned

Date

NOV 5 1941 19S. J. LEWIS

Scout