


Section 35 Township 11 Range 17W

Well No. #1 F. Hall

Company Altman

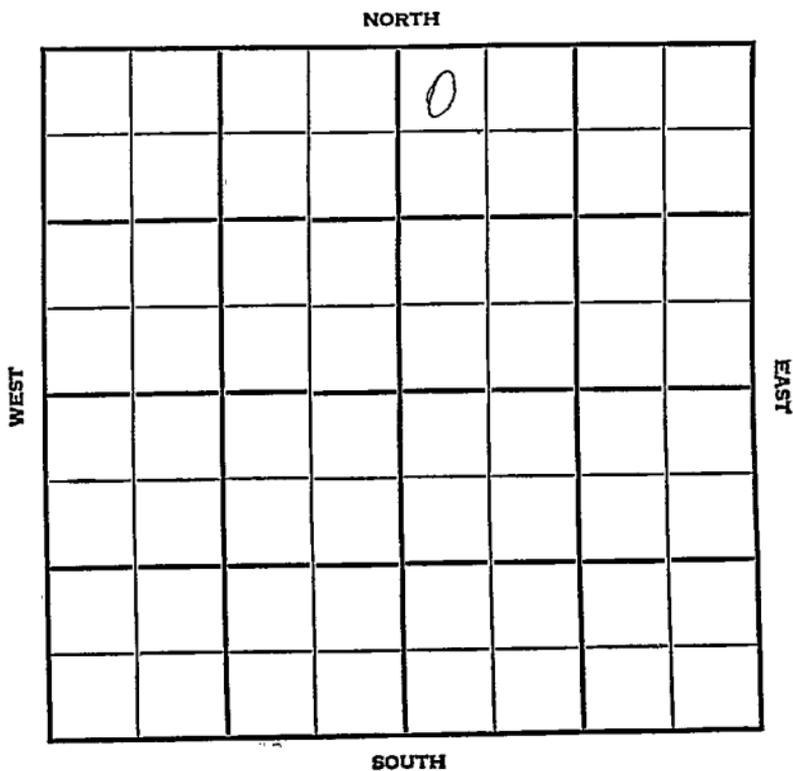

County Ellis Elev. 2093
 Sec. 35 Twp. 11 Rge. 17W
 Company Altman
 FarmName F. Hall No. 1

Co.

TOPS	DEPTH	LOG	DATUM
Anh.			
Tr.			
H.	3256		
Tr.	3281		
Dg.			
Bl.			
L.	3305		
K.C.			
B.K.C.	3541		
Ce.			
C.	3566		
M.			
M.			
K.			
Mz.			
Mo.			
V.			
S.			
S.			
A.			
R.			
Pe.			
G.			
TD.	3660		

Loc. in Sec. NW NW NE
200' NL
150' WL
 Geol. _____
 Contr. _____
 Pool _____
Bemis-Shutts

Lse.

	0
ABANDONED	
JAN 30 '57	

No.

Date Comm.

Sec.

T.

R.

Location 1-3-57 85/8

DIST 3344-92 1hr 30'

Md BHP 550 @ 3567

hold for 7/6 JAN 27 '57

DEA