

KANSAS

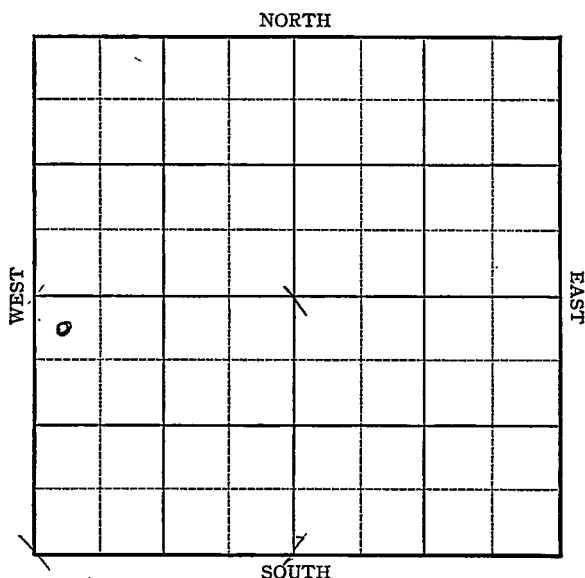
Ellis

FORM 51 5M 1-42 PETROL

Section 35 Township 11 Range 17-W

Well No. #1 Hall "B"

Company Anderson & Pritchard

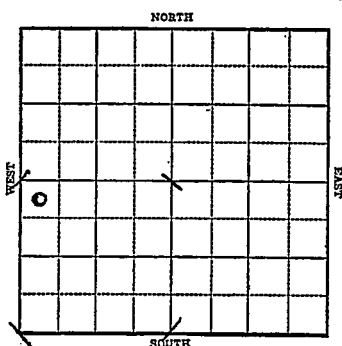


KANSAS

Ellis

Sec. 35 Twp. 11 R. 17-WWell No. #1 Hall "B" Farm
Anderson & Pritchard Company330 Ft. from N. Line Ft. from S. Line Ft. from E. Line330 Ft. from W. Line

Bemis Pool

1943 *elw. 2099* R E P O R T

7/28 Location

8/4 "

8/11 13" @ 87'
WOC.8/18 Dakota 570
Anhy 1296'
Drlg. 2465'

8/25 Drlg. 3315

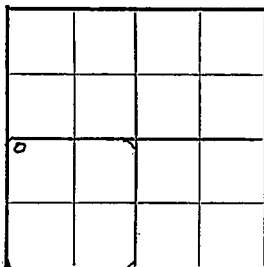
9/1 Lans 3340
Cong 3590 X
Rework Arb 3632
T.D. 3650**ABANDONED**

KANSAS**Ellis**Map No. 77 Sec. 35 Twp. 11 R. 17WWell No. 1 Hall "B"Anderson & Pritchard CompanyFIRST REPORT Contractor

NW SW

330 Ft. from N. Line Ft. from S. Line Ft. from E. Line330 Ft. from W. Line

SECTION PLAT

BEMIS POOLLocation XXXRig up

Drilling and Remarks:

RECORD

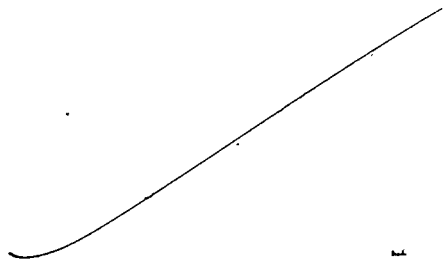
Cased in., ft.Sand Gas Oil Total Depth

PRODUCTION

1st 24 hrs. Nat. 1st 24 hrs. after shot Gas Cu. Ft.Dry Hole Abandoned

Date

JUL 2 8 1943 19S. J. LEWIS Scout



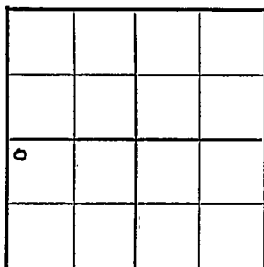
Misc. Small Maps	<i>Chap</i>
Cards	<i>Beapt</i>
Tracing	<i>ML</i>
France Map	<i>✓</i>
Scarborough Map	<i>✓</i>
Moody Map	<i>ML</i>
Geological Dept.	
Moody Flat Book	

KANSAS

Map No. 71 Sec. 35 Twp. 11 R. 17WWell No. 1 Hall "B"Anderson & Prichard CompanyABANDONED Contractor

NW SW

SECTION PLAT

330 Ft. from N. Line Ft. from S. Line Ft. from E. Line330 Ft. from W. Line

Bemis Pool

Location Rig up

Drilling and Remarks:

*Lams 3340**Cong 3590**Re-worked 3632*

RECORD

Cased in., ft.Sand Gas Oil Total Depth 3650

PRODUCTION

1st 24 hrs. Nat. 1st 24 hrs. after shot Gas Cu. Ft.Dry Hole Abandoned

Date

SEP 1 1943S. J. LEWIS Scout

9/2/43

Please check Top Cong. you have 359

Oma.



Misc. Small Maps	<i>Oma</i>
Cards	<i>Madge</i>
Tracing	<i>ONE</i>
France Map	<i>[initials]</i>
Scarborough Map	<i>[initials]</i>
Moody Map	<i>ONE</i>
Geological Dept.	<i>1</i>
Moody Plat Book	