

KANSAS


Ellis

FORM 51 5M 1-42 PETROL

Section 35 Township 11 Range 17W

Well No. #2 Hall "J"

Company Cities Service Oil

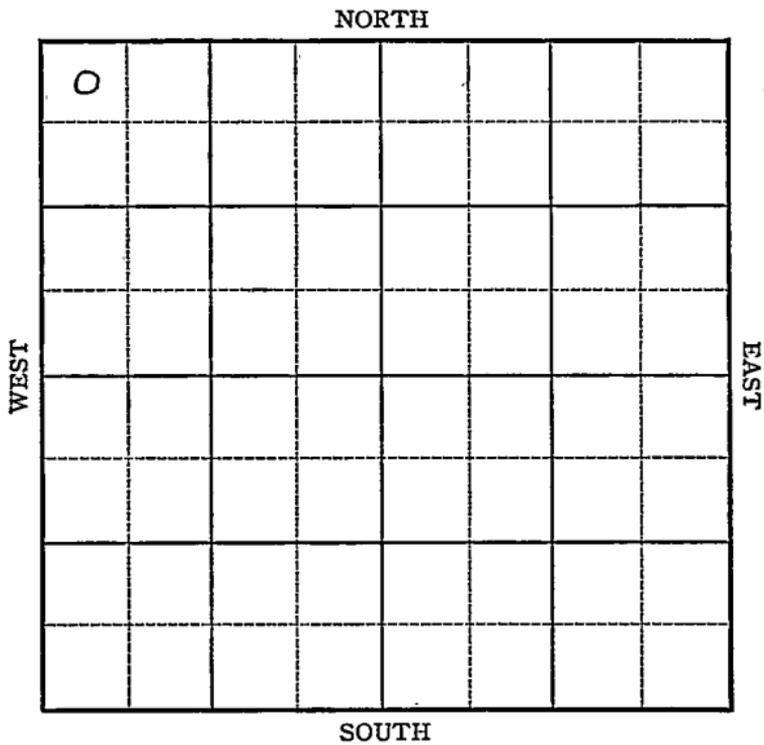

Sec. 35 Twp. 11 R. 17-W

Well No. #2 Hall "J" Farm

Cities Service Oil Company

Bemis


330 Ft. from N. Line

_____ Ft. from S. Line

_____ Ft. from E. Line

330 Ft. from W. Line

Elev. 1963

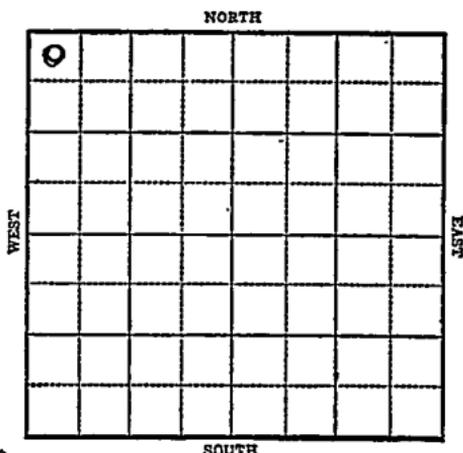

1943

R E P O R T

3/24 8" Casing set 234'
Waiting on cement
3/31 Drlg. 2510
4/14 Lans 3202
BKC 3428
Arb. 3608
T.D. 3638'

ABANDONED

