


Section 35 Township 11 Range 17-W

Well No. #4, Hall "J"

Company Cities Service Oil Company

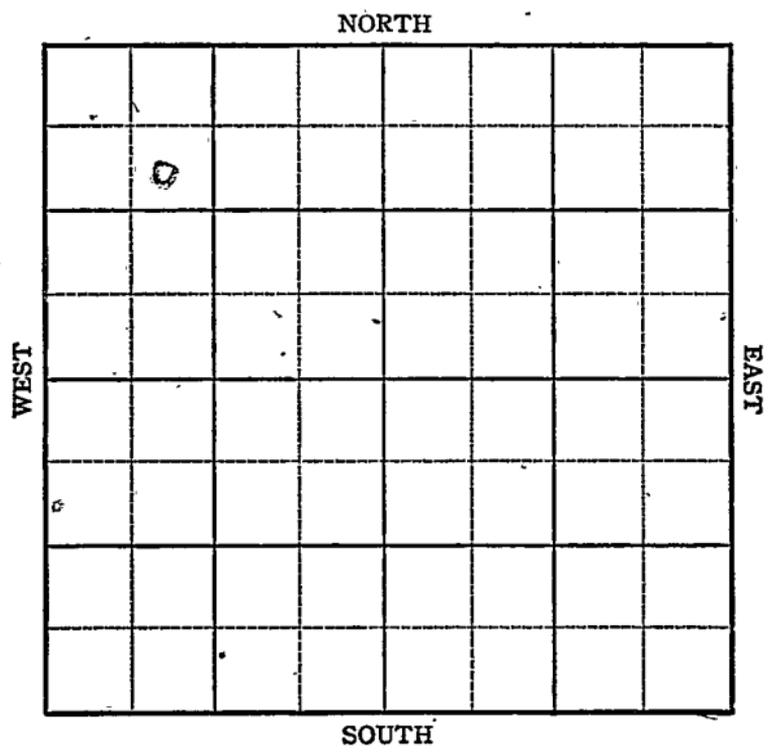

KANSAS

Ellis county ✓

Sec. 35 Twp. 11 R. 17-W

Well No. #4, Hall "J" Farm _____


Cities Service Oil Company Company
Bemis Pool

1040' Ft. from N. Line

_____ Ft. from S. Line

_____ Ft. from E. Line

990' Ft. from W. Line

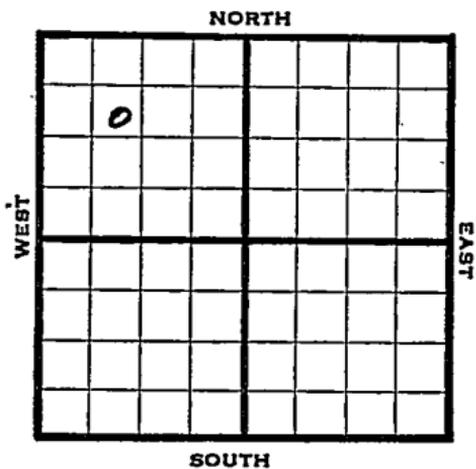

SE NW NW

1946 **REPORT**

Elev. 1970'

12/3 Location.

12/10 8" @ 1080'

Drlg 2374'

12/17 Drlg 3505'

1947

1/2 Lans 3170'

Arb 3519'

ED 3545'

ABANDONED

Map No. 71 Sec. 35 Twp. 11 R. 17WWell No. 4 Hall "J"

Cities Service Company

FIRST REPORT Contractor

SE NW NW

SECTION PLAT

1040 Ft. from N. Line Ft. from S. Line Ft. from E. Line990 Ft. from W. Line

Ellis County

Location XRig up

Drilling and Remarks:

RECORD

Cased in., ft.Sand Gas Oil Total Depth

PRODUCTION

1st 24 hrs. Nat. 1st 24 hrs. after shot Gas Cu. Ft.Dry Hole Abandoned

Date

DEC 4 1946 19

S. J. LEWIS Scout

Map No. 71 Sec. 35 Twp. 11 R. 17W

Well No. 4 Hall "J"

Cities Service Company

ABANDONED Contractor

SE NW NW

E 11/970
SECTION PLAT

1040 Ft. from N. Line

_____ Ft. from S. Line

_____ Ft. from E. Line

990 Ft. from W. Line

0			

Ellis County

RECORD

Location _____

Cased _____ in., _____ ft.

Rig up _____

Sand _____

Drilling and Remarks:

Gas _____

Oil _____

Total Depth 3025

*Lane 3170
C 8 3519*

PRODUCTION

1st 24 hrs. Nat. _____

1st 24 hrs. after shot _____

Gas _____ Cu. Ft.

Dry Hole _____

Abandoned _____

Date

JAN 2 1947

19

S. J. LEWIS Scout