

Ellis

KANSAS

Section 35 Township 11 Range 19WWell No. #1 JensenCompany C & G Drlg.

0							

NORTH

WEST

EAST

SOUTH

12

Ellis KANSAS ✓

Sec. 35 Twp. 11 R. 19 WWell No. # 1 Jensen FarmG & G Drlg. CompanyLohman & Johnson ContractorWildcat330 Ft. from N. Line


Ft. from S. Line

Ft. from E. Line

330 Ft. from W. Line

NW NW SW

Skelly & AtI. - DHM

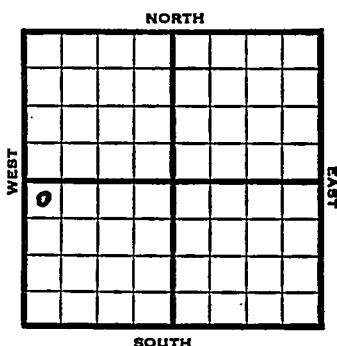

1953 Elev. 2171' REPORT

2/25 Spud 2-19-53
8" @ 169 Anhy 1518'
Drlg. 2375'

3/4 Spud 2-19-53
D&A
TD 3746
8" @ 169
Anhy 1518, Top 3180; Heeb 3408,
Tor 3428, L ans 3448,
DST 3529-35, opn 1 hr., rec.
180' sw, 975#
B KC 3667, Simp 3711, Arb 3738
DST 3739-46, opn 1 hr., rec.
127' sw, 950#
TD 3746
D&A

ABANDONED

County **Ellis** State **Kansas**

Sec. 35 (Blk.) 11 (Sur.) 19W Map No.

Operator G & G Drfg.

Well No. 1 Farm Jensen

Elev.	Location	NW	NE	SW
-------	----------	----	----	----

0

FIRST REPORT

330 Ft. From N Line SW

330 Ft. From V Line Quarter

1st. Report FEB 25 1953

Completion

Remarks Skelly & Atl. - DEM

Lehman & Johnson - Contr.

Spudding Date **2-19-53**

Drig. Data Wildcat

8" @ 169 Anhv 1518 drlg. 2375

J. G. McGEHEE

J. G. McGEHEE