


Ellis

KANSAS

SECTION 35 TOWNSHIP 11S RANGE 19W

WELL NO. #1 Vine "B"

COMPANY Darby, Cook & Galloway & Oil Trading

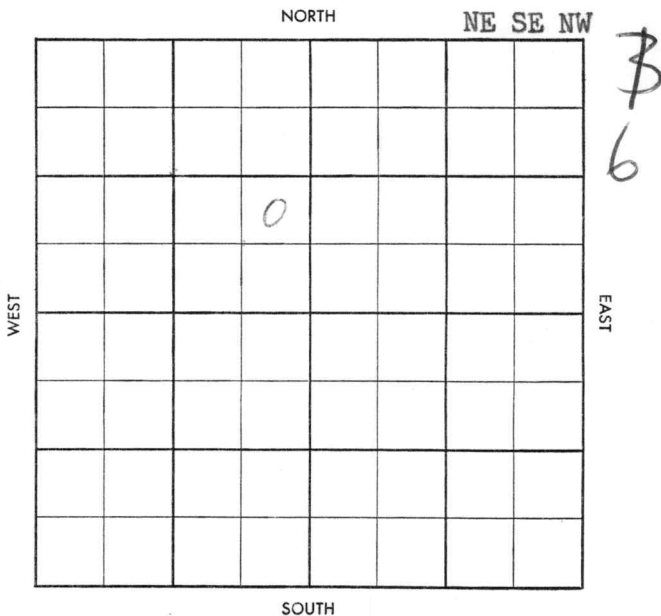

~~Section 35~~
~~Section 36~~

County Ellis Elev. _____
Sec. 35 Twp. (11S) Rge. 19W
Company Darby, Cook & Galloway & Oil Trading
Farm Name Vine "B" No. 1

TOPS	DEPTH	LOG	DATUM
Anh.			
Tp.			
H.			
Tr.			
Dg.			
B.L.			
L.			
K.C.			
B.K.C.			
Ce.			
C.			
M.			
M.			
K.			
Mz.			
Mq.			
V.			
S.			
S.			
A.			
R.			
Pf.			
G.			
T.D.			

Loc. in Sec. _____
NE SE NW
Geol. _____
Contr. Cook & Galloway #2
Pool Solomon SE



Date Comm. MIRT

Co.
Lse.
No.
Sec.
T.
R.

Two ✓ No
 Co. Foot 170

S-513-B

County Ellis Elev. 2118 OF 31318
 Sec. 35 Twp. 11S Rge. 19W
 Company Darby, Cook & Galloway & Oil Trading
 Farm Name Vine "B" No. 1

TOPS	DEPTH	LOG	DATUM
Anh.	1461		
Tp.	3122		
H.	3346		
Tr.	3365		
Dg.	3380		
B.L.			
L.	3388		
K.C.			
B.K.C.	3602		
Ce. <u>man</u>	3609		
C. <u>54</u>	3627		
M.			
M.			
K.			
Mz.			
Mq.			
V.			
S. <u>54</u>	3638		
S.			
A.	3664		
R.			
Pf.			
G.			
T.D.	3669		

Loc. in Sec. NE SE NW
 Geol.
 Contr. Cook & Galloway #2
 Pool Solomon SE



Date Comm. 7-1-58 8" 209/155
MIRT JUL 10 '58 Ø 3343 JUL 15 '58 DST
3665-69 2hrs, 180 free oil BHP
775/30 5 1/2 3663/100 CO
JUL 23 '58 CO 3669 \$ 5 BOPH NW
NT \$ 37.8 BO NW 7hrs DD 3669
1/2 \$ Ld T & R JUL 30 '58 wopos
AUG 6 '58 pop P 190 BO pd NW 40
pot AUG 13 '58 Phyp 489 BO pd NW 9W
19° orb 3663-69 1/2

Co.
 T.
 No.
 Sec.
 T.
 R.