


KANSAS Trego

FORM 51 IOM 12-46 PETROL

Section 35 Township 11 Range 22W

Well No. 56 Strat (#1 Hillman)

Company Continental & Skelly

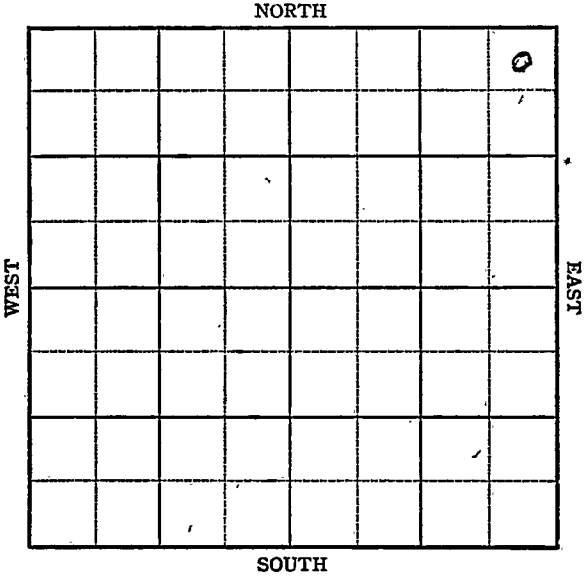

KANSAS

Trego



Sec. 35 Twp. 11 R. 22-W

Well No. #56 Strat (#1 Hillman) Farm

Continental & Skelly Company


330 Ft. from N. Line

\_\_\_\_\_ Ft. from S. Line

330 Ft. from E. Line

\_\_\_\_\_ Ft. from W. Line

NE/c

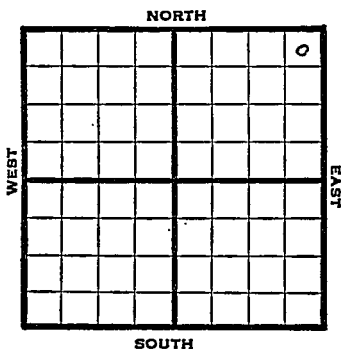

1947 Elev. 2328' REPORT

5/14	Location
5/20	"
5/27	Drlg. 3540'
6/3	Drlg. 4006'
6/11	Lans. 3606'
	Cong. 3940'
	Arb. 4098'
	TD 4135'

**ABANDONED**

Kansas

Wildcat **KANSAS**

Map No. K69 Sec. 35 Twp. 11 R. 22W

Well No. 56 Strat (#1 Hillman)

Continental & Skelly Company

**FIRST REPORT**

Contractor

NE/C

**SECTION PLAT**

330 Ft. from N. Line

\_\_\_\_\_ Ft. from S. Line

330 Ft. from E. Line

\_\_\_\_\_ Ft. from W. Line

			D

Trego County

Location X

Rig up \_\_\_\_\_

Drilling and Remarks:

**RECORD**

Cased \_\_\_\_\_ in., \_\_\_\_\_ ft.

Sand \_\_\_\_\_

Gas \_\_\_\_\_

Oil \_\_\_\_\_

Total Depth \_\_\_\_\_

**PRODUCTION**

1st 24 hrs. Nat. \_\_\_\_\_

1st 24 hrs. after shot \_\_\_\_\_

Gas \_\_\_\_\_ Cu. Ft.

Dry Hole \_\_\_\_\_

Abandoned \_\_\_\_\_

Date

MAY 14 1947 19

S. J. LEWIS Scout

Map No. 69 Sec. 35 Twp. 11 R. 22W

Well No. 56 Strat (#1 Hillman)

Continental & Skelly Company

**ABANDONED**

Contractor

NE/C

E. 1.2328  
**SECTION PLAT**

330 Ft. from N. Line

\_\_\_\_\_ Ft. from S. Line

330 Ft. from E. Line

\_\_\_\_\_ Ft. from W. Line

			o

Trego County

Location \_\_\_\_\_

Rig up \_\_\_\_\_

Drilling and Remarks:

Lease 3606

Conq 8940

Co 4098

**RECORD**

Cased \_\_\_\_\_ in., \_\_\_\_\_ ft.

Sand \_\_\_\_\_

Gas \_\_\_\_\_

Oil \_\_\_\_\_

Total Depth 4135

**PRODUCTION**

1st 24 hrs. Nat. \_\_\_\_\_

1st 24 hrs. after shot \_\_\_\_\_

Gas \_\_\_\_\_ Cu. Ft.

Dry Hole \_\_\_\_\_

Abandoned \_\_\_\_\_

Date

JUN 11 1947 19

S. J. LEWIS Scout