


Ellis

KANSAS

SECTION 36 TOWNSHIP 11 RANGE 16W

WELL NO. #1 Chrisler

COMPANY Woodman & Iannitti & F. Oyster

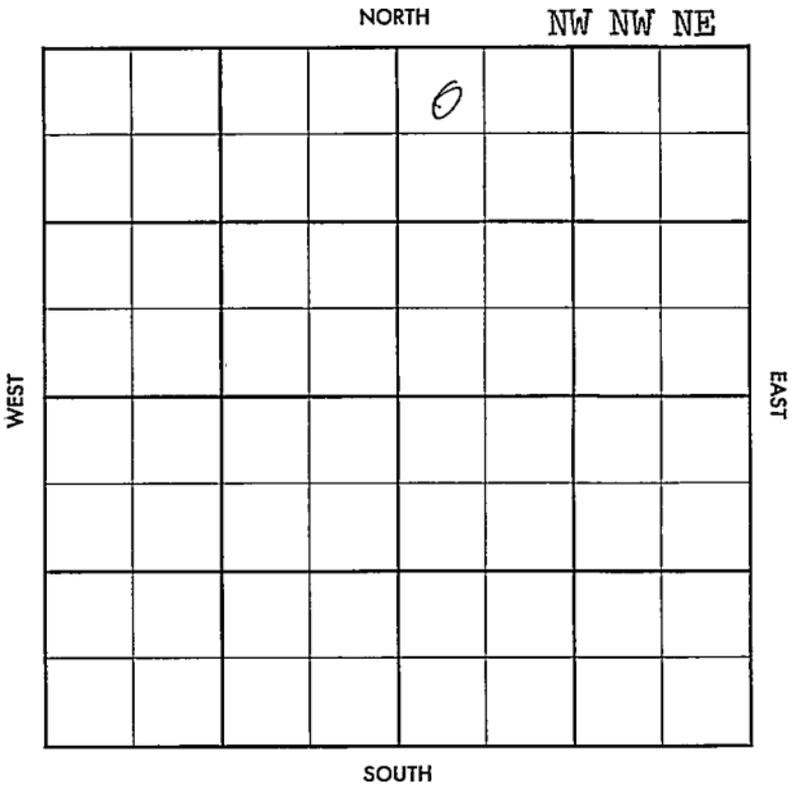

WILDCAT

FORM 513 SUNRAY

County EMlis Elev. 1772 DF
 Sec. 36 Twp. 11 Rge. 16W
 Company Woodman & Tannitti & F. Oyster
 Farm Name Chrisler No. 1

Co.

TOPS	DEPTH	LOG	DATUM
Anh.			
Tp.			
H.			
Tr.			
Dg.			
Bl.			
L.			
K.C.			
B.K.C.			
Ce.			
C.			
M.			
M.			
K.			
Mz.			
Me.			
V.			
S.			
S.			
A.			
R.			
PE.			
G.			
T.D.			

Loc. in Sec. NW NW NE

Geol. _____

Contr. _____

Co. Tools _____

Pool _____

Wildcat

FIRST REPORT
 APR 24 1957

Lse.

No.

Sec.

T.

R.

Date Comm. 4-18-57 Texas (DHM)
8" @ 941, Drlg. 2105

County Ellis Elev. 1772 DF
 Sec. 36 Twp. 11 Rge. 16W
 Company Woodman & Tannitti & F. Oyster
 FarmName Chrisler No. 1

TOPS	DEPTH	LOG	DATUM
Anh.	936		
TP.			
H.	2962		
Tr.	2980		
Dg.			
Bl.			
L.	3010		
K.C.			
R.K.C.			
Ce.			
C.	3314		
M.			
M.			
K.			
Mz.			
Mo.			
V.			
S.	5h 3442		
S.			
A.	3474		
R.			
PE.			
G.			
T.D.	3500		

Loc. in Sec.


Geol.

Contr.

Co. Tools

Prod.

Wilcox

ABANDONED

MAY 1 1957

Date Comm. 4-18-57 Texas (DHP)

8" @ 941, Drlg. 2105 MAY 1 '57

D & W

Co

Use

No.

Sec.

T.

R.