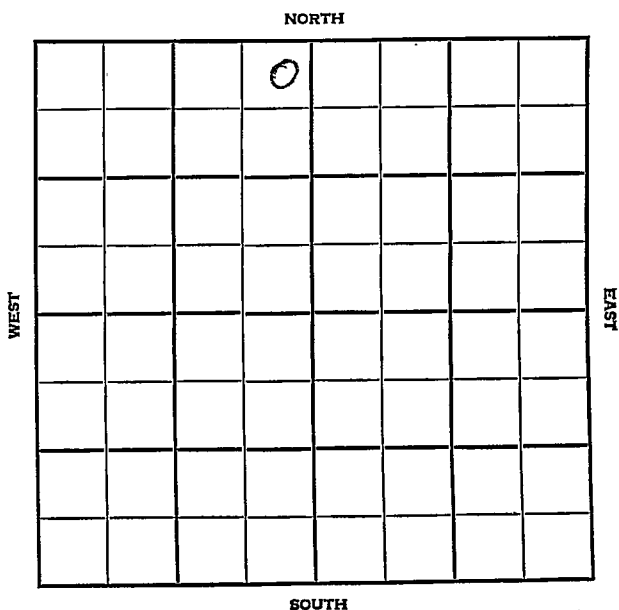


Section 36 Township 11 Range 18 WWell No. #5 MeierCompany Walters Drlg.

Ellis

KANSAS

SEC.	36	TWP.	11	R.	18W
------	----	------	----	----	-----

WELL NO. 5 Meier FARM

COMPANY Walters Drlg.

CONTRACTOR

Co. Tools

Walter Pool


300' Ft. from N. Line

Ft. from S. Line

300' Ft. from E. Line

Ft. from W. Line

NE NE NW

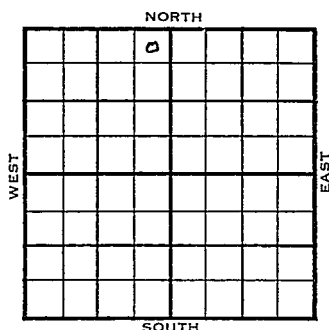

1955	ELEVATION	REPORT
------	-----------	--------

5/25

MIR

Comm 5-23-55

8 5/8" @ 172/125 5 1/2" @ 3647, CO to
 3648 S 7/8" bo 1 bw 1 hr. 500 A. FU 1250'
 wtr. 11 hr. DD 3656 FU 1245' wtr. 5
 go 24 hrs. D&A

Tops:	Depth	Datum
Anh.	1340	
Tp.	3071	971
H.	3305	1205
L.	3351	1251
A.	3646	1546
TD	3648	

ABANDONED

County Ellis State KansasSec. 36 (Blk.) 11 (Sur.) 18W Map No.Operator Walters Drlg.Well No. 5 Farm MeierElev. Location NE NE NW

			0				

330 Ft. From N Line NW330 Ft. From E Line Quarter1st. Report MAY 25 1955

Completion

Remarks

Co. tools

Spudding Date

Drlg. Data

Walter PoolM I R

2098 DF

County Ellis Elev. 2100 KBSec. 36 Twp. 11 Rge. 18WCompany Walters Drlg.FarmName Meier No. 5

TOPS	DEPTH	LOG	DATUM	Loc. in Sec.																														
Anh.	<u>1340</u>			<u>NE NE NW</u>																														
TP.	<u>3071</u>		<u>971</u>																															
H.	<u>3305</u>		<u>1205</u>																															
Tr.																																		
Dg.																																		
BL.																																		
L.	<u>3351</u>		<u>1251</u>	Geol.																														
K.C.				Contr.																														
B.K.C.				Co. tools																														
Ce.				Pool																														
C.				<u>Walter</u>																														
M.				<table border="1"> <tr><td></td><td>0</td><td></td></tr> <tr><td></td><td></td><td></td></tr> <tr><td></td><td></td><td></td></tr> <tr><td></td><td></td><td></td></tr> <tr><td></td><td></td><td></td></tr> <tr><td></td><td></td><td></td></tr> <tr><td></td><td></td><td></td></tr> <tr><td></td><td></td><td></td></tr> <tr><td></td><td></td><td></td></tr> <tr><td></td><td></td><td></td></tr> </table>		0																												
	0																																	
M.																																		
K.																																		
Mz.																																		
Ma.																																		
V.																																		
S.																																		
S.																																		
A	<u>3646</u>		<u>1546</u>																															
R.																																		
Pe.																																		
G.																																		
TD.	<u>3648</u>																																	

Date Comm. 5-23-55

JUN 15 1955

8 5/8" @ 172/125 5 1/2" @ 3647 CO to 3648S/ 1/2 bo 1 bw 1 hr. 500 A FU 1250' wtr11 hr. DD 3656 FU 1245' wtr. 5 go 24 hr

D & A