


Section 36 Township 11 Range 18 W

Well No. # 1 Maier

Company Walters Drilg.

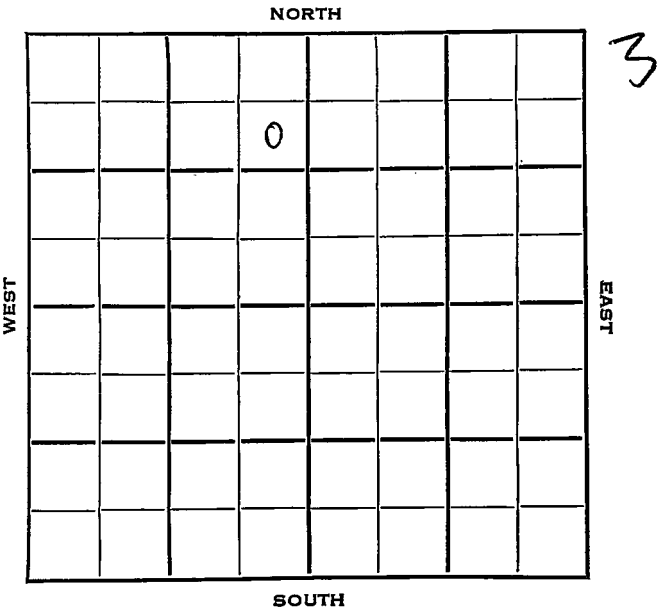

Ellis

KANSAS



SEC.	TWP.	R.
36	11	18 W
WELL NO.		
# 1 Maier		FARM
COMPANY		
Walters Drlg.		
CONTRACTOR		

Bemis-Shutts Pool


990 Ft. from N. Line

Ft. from S. Line

330 Ft. from E. Line


Ft. from W. Line

SE NE NW

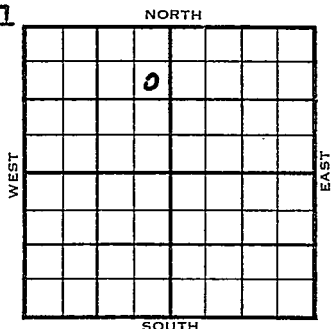

	ELEVATION	REPORT
1953	2110'	
12/2	Spud 11-28-53 8" @ 189	
12/9	Drlg. 816' Anhy 1354' Drlg. 3354'	
12/16	Heeb 3322', Lans 3370', Cong 3622', Simp 3637', Arb 3654' DST 3654-60', 1 hr., 340' oil, 20' ocm, 1000# RTD 3660' 5" @ 3655'	
1954 1/6	Spud 11-28-53 Oil well TD 3660 8" @ 189 Anhy 1354 Heeb 3322 Lans. 3370 Cong. 3622 Simp. 3637 Arb. 3654 DST 3654-60 open 1 hr rec 340' oil 20' OCM 1000# TD 3660 5" @ 3655 CO to 3660 FU 1800' oil 7 hr. P/5½ BOPH 6 hr. Comp. 50 BOPD	

COMPLETED

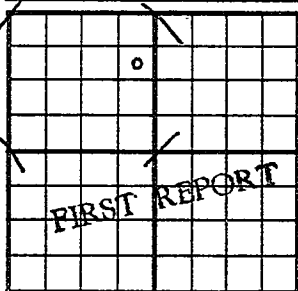
County Ellis State KansasSec. 36 (Blk. Twp.) 11 (Sur. Rge.) 18W Map No.Operator Walters Drlg.Well No. 1 Farm MaierElev. Location SE NE NW990 Ft. From N Line NW330 Ft. From E Line Quarter1st. Report DEC 2 1953

Completion

Remarks

Spudding Date 11-28-53Drlg. Data Bemis-Shutts Pool8" @ 189 drlg. 816

J. G. McGEHEE

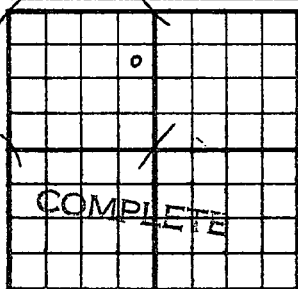County Ellis State KansasSec. 36 (Blk.) 11 (Sur.) 18W Map No. Operator Walters Drlg.Well No. 1 Farm MaierElev. 2110 Location SE NE NW990 Ft. From N Line NW330 Ft. From E Line Quarter1st. Report Completion JAN 6 1954Remarks Bemis-Shutts PoolSpudding Date 11-28-53Drlg. Data Oil well TD 36608" @ 189 Anhy 1354 Heeb. 3322Lans. 3370 Cong. 3622 Simp. 3637Arb. 3654 DST 3654-60 open 1 hr.Rec. 340' oil 20' ocm 1000# TD 36605" @ 3655 CO to 3660 FU 1800' oil7 hr. P/ 5½ boph 6 hr.Comp. 50 bopd

J. G. McGEHEE