

KANSAS

Form 51—5M—7-40—Palace

Ellis

Section 36 Township 11 Range 18-W

Well No. #9 Marshall Ranch

Company Lario Oil & Gas


Marshall Pool

NORTH

WEST

EAST

SOUTH

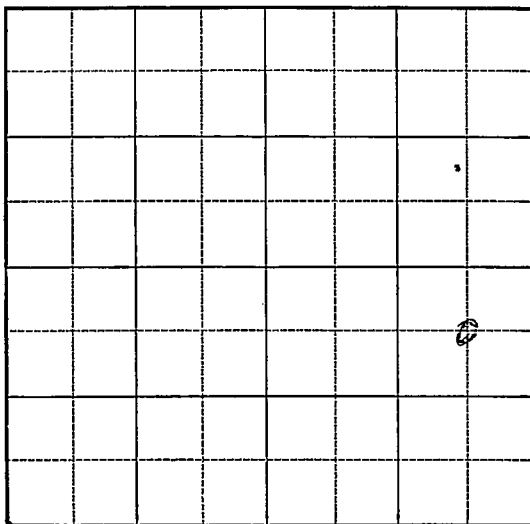

9


Sec. 36 Twp. 11 R. 18-WWell No. #9 Marshall Ranch FarmLario Oil & Gas

Company

(Marshall)

660 Ft. from N. Line Ft. from S. Line660 Ft. from E. Line Ft. from W. Line

Elev. 2121

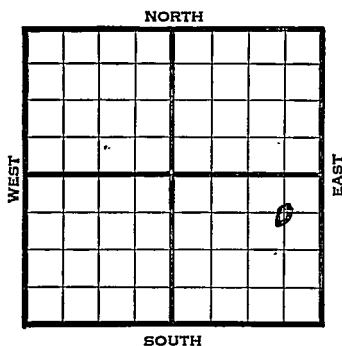

1940

REPORT

10/2 Location

10/10 "

10/17 "

10/24 "

10/31 "

11/7 R.U.R.

11/14 8" - 1355' Anhy 1327' WOC.

11/21 Drlg. 2930'

11/27 Neva 2920' Topeka 3100'

Lana. 3348' Arb. 3616-19' T.D.

5" - 3617' RUST.

12/4 Arb. 3616'

5" - 3617'

T.D. 3621'

Echometer potential 25,219 bbls.

Gravity 34.8

COMPLETED

Map No. 71 Sec. 36 Twp. 11 R. 18WWell No. 9 Marshall RanchLario Oil & Gas Company

Contractor

FIRST REPORT
C NE SE660 Ft. from N. Line Ft. from S. Line660 Ft. from E. Line Ft. from W. Line

MARSHALL POOL

SECTION PLAT

			o

Location XRig up

Drilling and Remarks:

RECORD

Cased in., ft.Sand Gas Oil Total Depth

PRODUCTION

1st 24 hrs. Nat. 1st 24 hrs. after shot Gas Cu. Ft.Dry Hole Abandoned

Date

OCT 2 194019S. J. LEWIS Scout

Misc Small Maps
Cards
Tracing
France Map
Scarborough Map
Moody Map
Geological Dept.
Moody Flat Book

Map No. 71 Sec. 36 Twp. 11 R. 18WWell No. 9 Marshall RanchLario

Company

Contractor

COMPLETED

C NE SE

660 Ft. from N. Line Ft. from S. Line660 Ft. from E. Line Ft. from W. Line

MARSHALL POOL

SECTION PLAT

			•

Location Rig up

Drilling and Remarks:

*On 83616**5" @ 3617.**Echo 825219.**Gr. 84.5***RECORD**Cased in., ft.Sand Gas Oil Total Depth 3621**PRODUCTION**1st 24 hrs. Nat. 1st 24 hrs. after shot Gas Cu. Ft.Dry Hole Abandoned

Date

DEC 4 1940 19S. J. LEWIS Scout

Misc. Small Maps

Cards

Tracing

France Map

Scarborough Map

Moody Map

Geological Dept.

Moody Flat Book