


Section 36c Township 11 c Range 18W

Well Number 2 Marshall

Company Lario

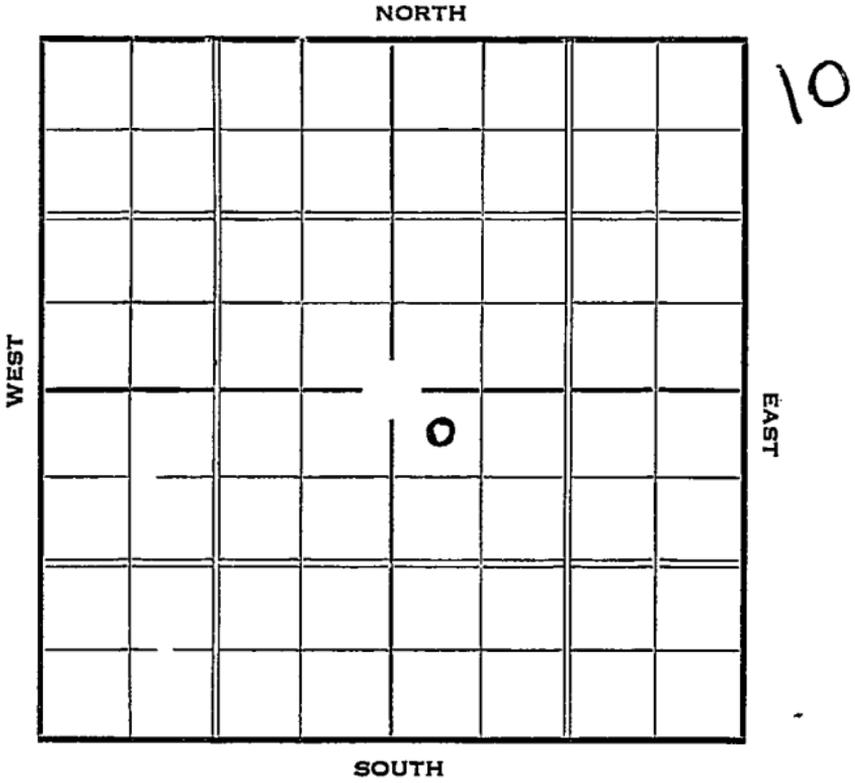

Sec. 36 Twp. 11 R. 18-W

Well No. #2 Marshall Farm

Lario Company


330 Ft. from N. Line

_____ Ft. from S. Line

_____ Ft. from E. Line

330 Ft. from W. Line

Elev. 2104

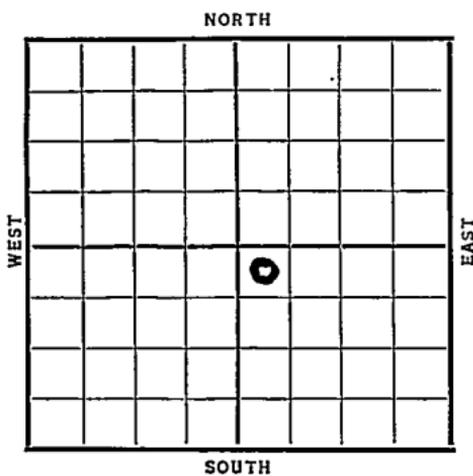

Date	REPORT
1/20	Location
1/28	Cellar.
2/4	R.O.G.
2/11	Rig
2/19	Rigging up
2/26	" "
3/4	" "
3/11	" "
3/11	" "
3/25	Anhydrate 1342'. 10" @ 1350'.
	Drlg. 2150'.
4/2	Drlg. 2900'.
4/8	Sil. 3642' run 8"
4/16	TD 3651' 2400' oil in hole
4/21	Sil. 3642'.
	T.D. 3651'.
	Potential 1072 natural.
	COMPLETED

Map No. 71 Sec. 36 Twp: 11 R. 18W

Well No. 2 Marshall

Lario Company

Contractor

SECTION PLAT

330 Ft. from N. Line
_____ Ft. from S. Line
_____ Ft. from E. Line
330 Ft. from W. Line

		0	

FIRST REPORT

Location ✓

Rig up _____

Drilling and Remarks:

RECORD

Cased _____ in., _____ ft.

Sand _____

Gas _____

Oil _____

Total Depth _____

PRODUCTION

1st 24 hrs. Nat. _____

1st 24 hrs. after shot _____

Gas _____ Cu. Ft.

Dry Hole _____

Abandoned _____

Date

JAN 20 1937 19

S. J. LEWIS Scout

KANSAS *Ellis*

Map No. _____ Sec. 36 Twp. 11 R. 18W

Well No. 2. Marshall

Lariv Company

Contractor _____

SECTION PLAT

		0	

320 Ft. from N. Line

_____ Ft. from S. Line

_____ Ft. from E. Line

330 Ft. from W. Line

COMPLETED

Location _____

Rig up _____

Drilling and Remarks:

Sil 3642

Potential

1072 natural

RECORD

Cased _____ in., _____ ft.

Sand _____

Gas _____

Oil _____

Total Depth 3651

PRODUCTION

1st 24 hrs. Nat. _____

1st 24 hrs. after shot _____

Gas _____ Cu. Ft.

Dry Hole _____

Abandoned _____

Date

APR 21 1937 19

S. J. LEWIS Scout