


Section 36 Township 11 Range 18-W

Well No. 7 Marshall

Company Lario

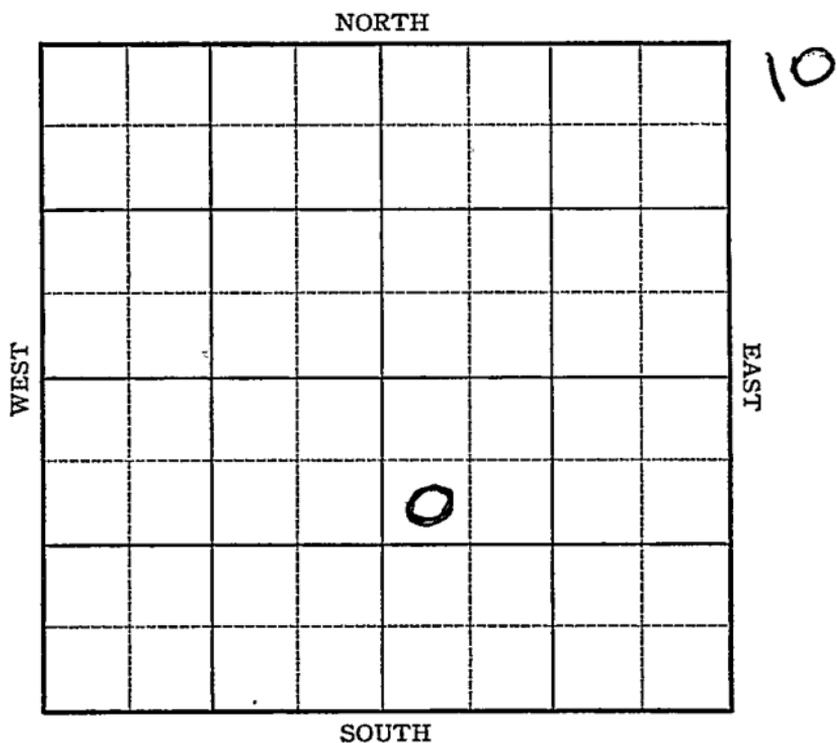

Sec. 36 Twp. 11 R. 18W

Well No. #7 Marshall Farm

Lario Company

SW NE SE


990 Ft. from N. Line

\_\_\_\_\_ Ft. from S. Line

~~990~~ Ft. from E. Line

330 Ft. from W. Line

Elev. 2104

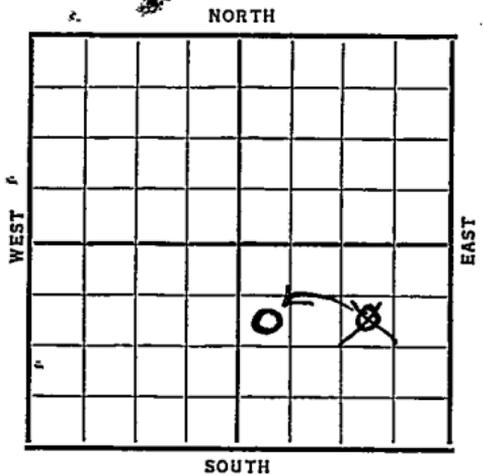

Date	REPORT
1937	
8/25	MAT.
9/3	R. R.
9/10	Drlg. 840'.
9/17	Anhy 1345'. 10" @ 1360'. Drlg. 2106'.
9/24	Drlg. 2860'.
10/2	Sil. 3625'. 7" @ 3626'. T.D. 3631'. Good saturation.
10/8	Sil. & 7" @ 3621' (Corrected) T.D. 3626'. RUST. S.O.
10/15	T.D. 3635'. 2800' oil 2½ hrs.
	<b>OVER</b>

1937

10/20 10" @ 1345'.

7" @ 3626'.

Sil. 3625' (Corrected)

T.D. 3636'.

Potential 2149 bbls. Nat.

COMPLETED

Map No. \_\_\_\_\_ Sec. 36 Twp. 11 R. 18WWell No. 7-MarshallLario Company

## FIRST REPORT

Contractor

sw ne se990 Ft. from N. Line

\_\_\_\_\_ Ft. from S. Line

990 Ft. from E. Line

\_\_\_\_\_ Ft. from W. Line

## SECTION PLAT

			0

Location \_\_\_\_\_

Rig up \_\_\_\_\_

Drilling and Remarks:

Mat.

## RECORD

Cased \_\_\_\_\_ in., \_\_\_\_\_ ft.

Sand \_\_\_\_\_

Gas \_\_\_\_\_

Oil \_\_\_\_\_

Total Depth \_\_\_\_\_

## PRODUCTION

1st 24 hrs. Nat. \_\_\_\_\_

1st 24-hrs. after shot \_\_\_\_\_

Gas \_\_\_\_\_ Cu. Ft.

Dry Hole \_\_\_\_\_

Abandoned \_\_\_\_\_

Date

AUG 25 1937 19

H. D. Hatfield Scout

*Ellis* KANSAS

Map No. \_\_\_\_\_ Sec. 36 Twp. 11 R. 18<sup>W</sup>

Well No. 7-Marshall


Lario Company

Contractor

**FIRST REPORTS**

990 Ft. from N. Line  
 \_\_\_\_\_ Ft. from S. Line  
 \_\_\_\_\_ Ft. from E. Line  
330 Ft. from W. Line

**SECTION PLAT**

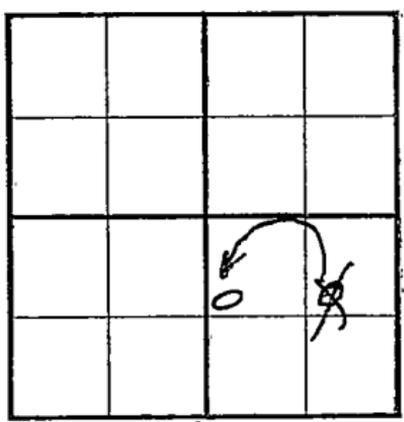

**FIRST REPORTS**

Location \_\_\_\_\_

Rig up \_\_\_\_\_

Drilling and Remarks:

*incorrectly reported  
 By Lario as being  
 located in SWNE SE  
 Should be  
 SWNWSE*

**RECORD**

Cased \_\_\_\_\_ in., \_\_\_\_\_ ft.  
 Sand \_\_\_\_\_  
 Gas \_\_\_\_\_  
 Oil \_\_\_\_\_  
 Total Depth \_\_\_\_\_

**PRODUCTION**

1st 24 hrs. Nat: \_\_\_\_\_  
 1st 24 hrs. after shot \_\_\_\_\_  
 Gas \_\_\_\_\_ Cu. Ft.  
 Dry Hole \_\_\_\_\_  
 Abandoned \_\_\_\_\_

Date

SEP 1 1937 19

H. D. Hatfield Scout

Map No. \_\_\_\_\_ Sec. 36 Twp. 11 R. 18W

Well No. 7 Marshall

Lario Company

Contractor

**COMPLETED**

**SECTION PLAT**

SW NW SE

990 Ft. from N. Line

\_\_\_\_\_ Ft. from S. Line

\_\_\_\_\_ Ft. from E. Line

330 Ft. from W. Line

		0	

Location \_\_\_\_\_

Rig up \_\_\_\_\_

Drilling and Remarks:

*POT-2149*

*N21,*

*10" - 1345*  
**RECORD**  
 Cased 7 in., 3625 ft.  
 Sand 511 3625  
 Gas (corrected)  
 Oil \_\_\_\_\_  
 Total Depth 3636

**PRODUCTION**

1st 24 hrs. Nat. \_\_\_\_\_  
 1st 24 hrs. after shot \_\_\_\_\_  
 Gas \_\_\_\_\_ Cu. Ft.  
 Dry Hole \_\_\_\_\_  
 Abandoned \_\_\_\_\_

Date

OCT 20 1937<sub>19</sub>

H. D. Hatfield Scout