


Ellis KANSAS

DX 78-1

Section 36 Township 11 Range 18W

Well No. 21 Marshall #4

Company Lario

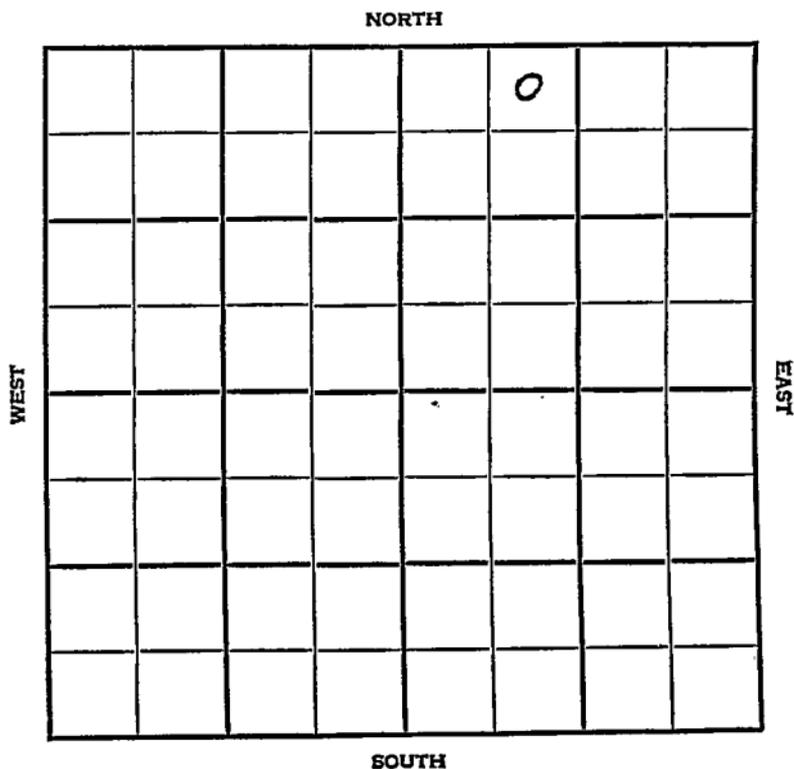

Ellis KANSAS

SEC. 36 TWP. 11 R. 18 W ✓

WELL NO. # 21 Marshall "A" FARM

COMPANY Lario

CONTRACTOR Walters Drlg.


Bemis Shutts Pool NORTH

330 Ft. from N. Line

Ft. from S. Line

Ft. from E. Line

990 Ft. from W. Line

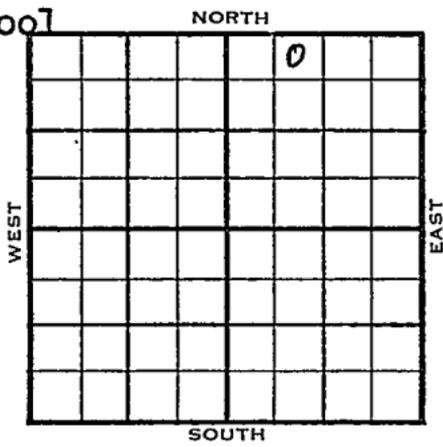

NE NW NE.

1954 ELEVATION 2107' REPORT

7/21 Spd 7-19-54
Drlg. 500'

8/18 Spud 7-19-54
Oil Well
TD 3645'
13" @ 263'
Heeb 3290', Lans 3334', Arb. 3623'
TD 3645'
7" @ 3642'
CO to 3645'
B/2 boph 500A
S/15 bo 15 bwph
Comp. 50 bopd 50% wtr.

COMPLETED

