

| | | |
|------|------|-----|
| SEC. | TWP. | R. |
| 36 | 11 | 18W |

WELL NO. #4 Meier. FARM

COMPANY Walters Drlg.

CONTRACTOR Co. Tools.


Bemis-Shutts Pool

_____ Ft. from N. Line

990 _____ Ft. from S. Line

_____ Ft. from E. Line

330 _____ Ft. from W. Line

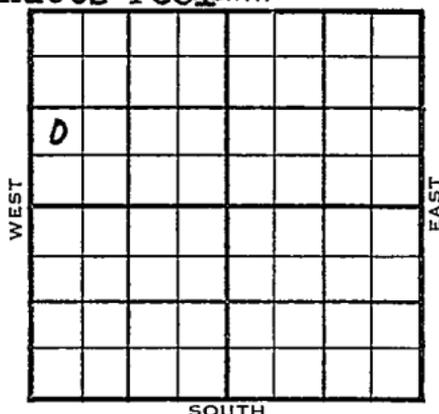

NW SW NW

| 1955 | ELEVATION 1959 | REPORT |
|------|----------------|--------|
|------|----------------|--------|

4/13 Spud 4-11-55
8" @ 170'

WOC.

4/27 Spud 4-11-55

D & A

TD 3533'

8" @ 170'

Anhy 1216', Heeb 3178', Top 2948'

Tor. 3199', KC. 3226', Cong. 3481'

Simp 3504', Arb. 3523'

TD 3533'

D & A

ABANDONED

County Ellis State Kansas

Sec. 36 (Blk. Twp.) 11 (Sur. Rge.) 18W Map No.

Operator Walters Drlg.

Well No. 4 Farm Meier

Elev. 1959 Location NW SW NW

| | | | | | |
|--|--|--|--|--|--|
| | | | | | |
| | | | | | |
990 Ft. From S Line NW

330 Ft. From W Line Quarter

1st. Report

Completion APR 27 1955

Remarks Bemis-Shutts Pool

Co. tools

Spudding Date 4-11-55

Drlg. Data D & A TD 3533

8" @ 170 Anhy 1216 Heeb. 3178

Top. 2948 Tor. 3199 KC 3226

Cong. 3481 Simp. 3504 Arb. 3523

TD 3533

D & A

FABEN GILSTRAP