
FORM 51 10M 8-47

KANSAS

Section 36 Township 11 Range 17W

Well No. #3 Samuelson

Company Anderson-Prichard

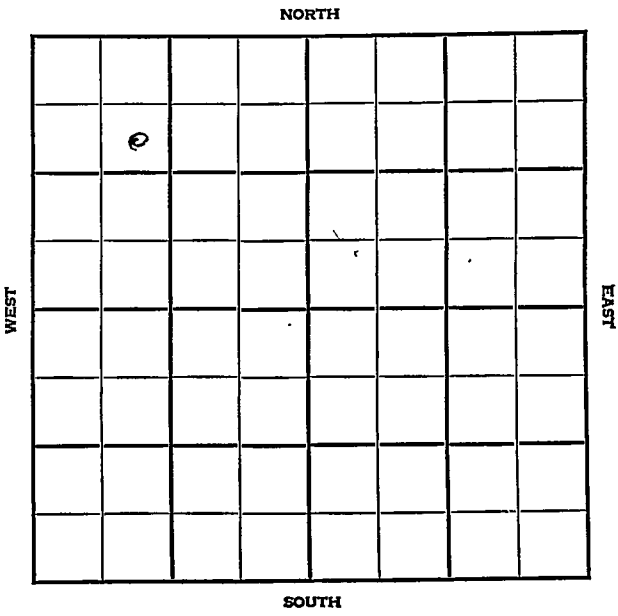

FORM 252-A
5M 9-47 PETROL

KANSAS

Ellis

Sec. 36 Twp. 11 R. 17W

Well No. #3 Samuelson Farm

Anderson-Brichard Company

Bemis


990 Ft. from N. Line

Ft. from S. Line

Ft. from E. Line

990 Ft. from W. Line

SE NW NW

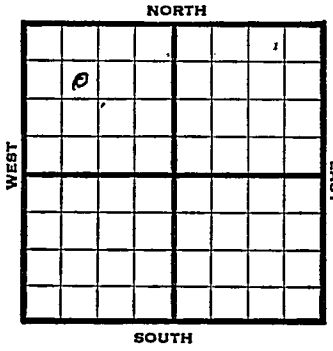

1947	Elev. 2097' REPORT
11/19	Location
11/25	RUR
12/3	13" @ 97' Drlg. 1970'
12/10	Heebner 3266' Lansing 3324' Drlg.3336'
12/17	Arbuckle 3580' TD 3587' 5" @ 3582' RUST
12/30	"
1948 1/7	TD 3625' 2500 acid.
1/14	"
1/21	"
12/26	Pump 58 bbls oil SW in 7 hrs.
2/4	"
2/11	"
2/18	"

OVER

1948

2/25 Arb. 3580'
5" @ 3582'
Pump 194 oil + 4% W/pot
36.0 Gr.
TD 3625'
Comp.

COMPLETED

Form 26 200 Bks. 10-46 Petrol

Bemis Pool

Kansas

Map No. _____ Sec. 36 Twp. 11 R. 17W

Well No. 1 Samuelson

Anderson-Prichard Company

FIRST REPORT Contractor

SE NW NW

990 Ft. from N. Line


_____ Ft. from S. Line

_____ Ft. from E. Line

990 Ft. from W. Line

Ellis County

SECTION PLAT

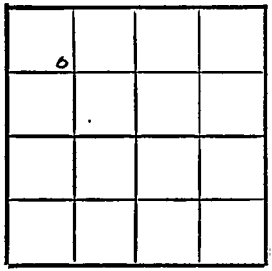

Location X

Rig up _____

Drilling and Remarks:

RECORD

Cased _____ in., _____ ft.

Sand _____

Gas _____

Oil _____

Total Depth _____

PRODUCTION

1st 24 hrs. Nat. _____

1st 24 hrs. after shot _____


Gas _____ Cu. Ft.

Dry Hole _____

Abandoned _____

Date

NOV 19 1947 19 S. J. LEWIS Scout

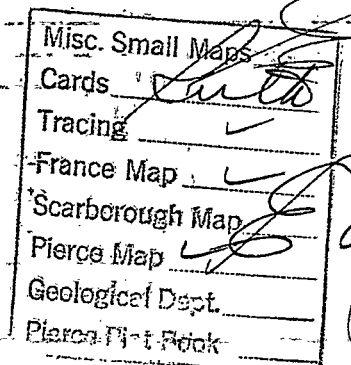
Misc. Small Maps
Cards
Tracing
France Map
Scarborough Map
Pierce Map
Geological Dept.
Pierce Plat Book

Form 26 200 Bks. 10-46 Petrol

Kansas

Bemis Pool

Map No. 71 Sec. 36 Twp. 11 R. 17W

Well No. 3 Samuelson

Anderson-Prichard Company

CORRECTION Contractor

SE NW NW


990 Ft. from N. Line

_____ Ft. from S. Line

_____ Ft. from E. Line

990 Ft. from W. Line

SECTION PLAT

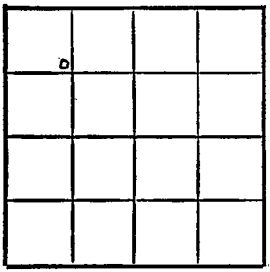

Ellis County

Location _____

Rig up _____

Drilling and Remarks:

Reported as
#1 Samuelson

RECORD

Cased _____ in., _____ ft.

Sand _____

Gas _____

Oil _____

Total Depth _____

PRODUCTION

1st 24 hrs. Nat. _____

1st 24 hrs. after shot _____

Gas _____ Cu. Ft.

Dry Hole _____


Abandoned _____

Date

DEC 3 1947

19

S. J. LEWIS Scout

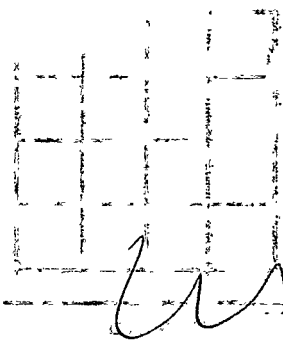

Misc. Small Maps
Cards
Tracing
France Map
Scarborough Map
Pierce Map
Geological Dept.
Pierce Plat Book

Form 26—200 Bks.—1-48—Palace

Bemis Pool

Kansas

Map No. 71 Sec. 36 Twp. 11 R. 17W

Well No. 3 Samuelson


Anderson-Prichard Company

COMPLETE Contractor

SE NW NW

E. 2087

SECTION PLAT

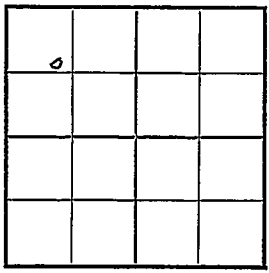

990 Ft. from N. Line

Ft. from S. Line

Ft. from E. Line

990 Ft. from W. Line

Ellis County

Location

Rig up

Drilling and Remarks:

Cr 3550

5" 3552

Pump 194 oil + 4% W.O.

86 Gr

RECORD

Cased in., ft.

Sand

Gas

Oil ✓

Total Depth 3625

PRODUCTION

1st 24 hrs. Nat.

1st 24 hrs. after shot

Gas Cu. Ft.


Dry Hole

Abandoned

Date

FEB 25 1948 19

S. J. LEWIS Scout

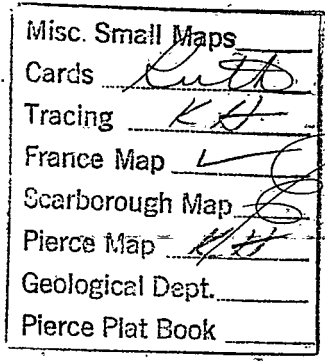
Misc. Small Maps
Cards
Tracing
France Map
Scarborough Map
Pierce Map
Geological Dept.
Pierce Plat Book