Ellis KANSAS


FORM 51 25M 3-49 PETROL

Section 36 Township 11 Range 17W

Well No. #5 Samuelson

Company Andersŏn-Prichard

Bemis Pool

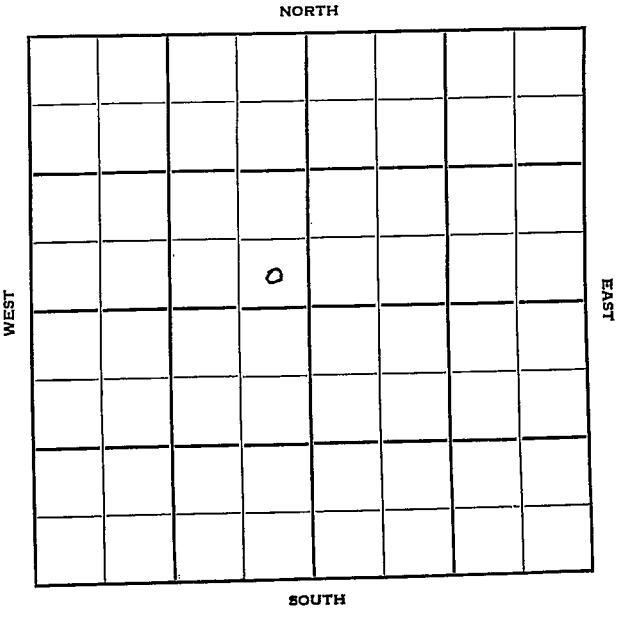

FORM 252-A
5M 10-48 PETROL

KANSAS

Ellis

Sec. 36 Twp. 11 R. 17W

Well No. #5 Samuelson Farm

Anderaon-Prichard Company


_____ Ft. from N. Line

330' Ft. from S. Line

330' Ft. from E. Line

_____ Ft. from W. Line

SE NW

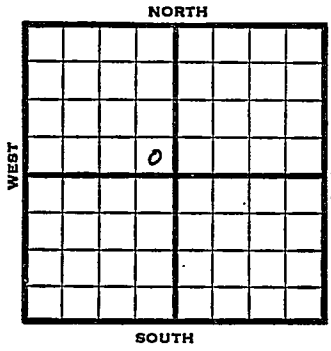

1949	Elev 2017' REPORT
12/21	Location
12/28	"
1950	
1/18	TD 3646'
	Anhy 1208'
	Heb 3303'
	Lans 3350'
	Cong 3510'
	Arb. 3547-6
	No shows.
	D&A
	Aband.
	ABANDONED

Form 26 200 Bks. 6-49 Petrol

Kansas

Bemis Pool

Map No. ____ Sec. 36 Twp. 11 R. 17W

Well No. 5 Samuelson


Anderson-Prichard Company

Contractor

SE NW

FIRST REPORT

SECTION PLAT

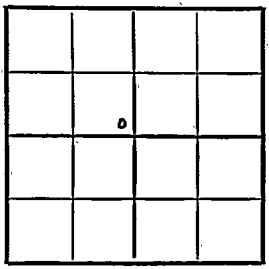

____ Ft. from N. Line

330 Ft. from S. Line

330 Ft. from E. Line

____ Ft. from W. Line

Ellis County

Location x

Rig up

Drilling and Remarks:

RECORD

Cased ____ in., ____ ft.

Sand

Gas

Oil

Total Depth

PRODUCTION

1st 24 hrs. Nat.

1st 24 hrs. after shot

Gas ____ Cu. Ft.

Dry Hole

Abandoned

Date

DEC 21 1949

S. J. LEWIS Scout

Form 26 200 Bks. 6-49 Petrol

Kansas

Bemis Pool

Map No. ____ Sec. 36 Twp. 11 R. 17W

Well No. 5 Samuelson


Anderson-Prichard Company

Contractor

SE NW

Elev. 2017

SECTION PLAT

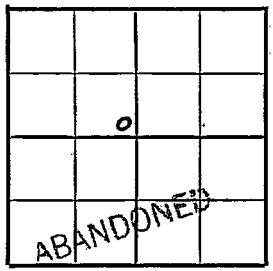

____ Ft. from N. Line

330 Ft. from S. Line

330 Ft. from E. Line

____ Ft. from W. Line

Ellis County

Location

Rig up

Drilling and Remarks:

Ark 1208
Heb 3303
Lan 3350
Cong 3510
Arb 3547-6
Mr. Shaw

RECORD

Cased ____ in., ____ ft.

Sand

Gas

Oil

Total Depth 3646

PRODUCTION

1st 24 hrs. Nat.

1st 24 hrs. after shot

Gas Cu. Ft.

Dry Hole

Abandoned

D & A

Date

JAN 18 1950

J. E. TYRA

Scout

19