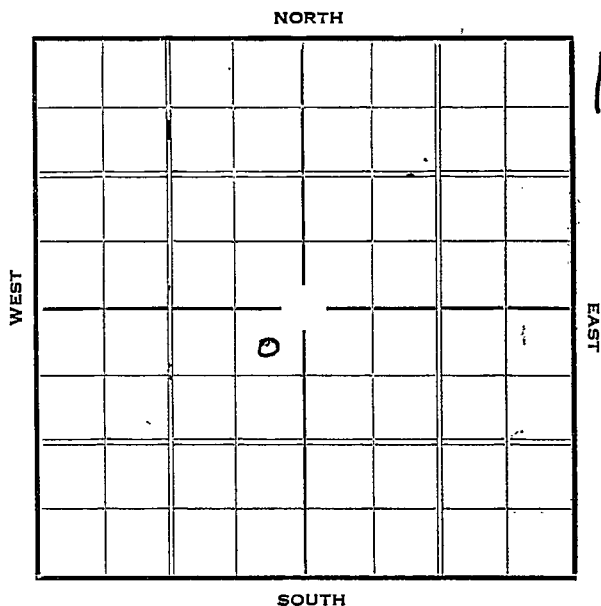
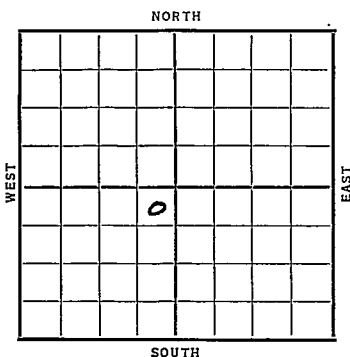


KANSAS

Section 36 Township 11 Range 18WWell Number 1 MeyersCompany Champlin Refg.

KANSAS

Ellis

Sec. 36 Twp. 11 R. 18-WWell No. #1 Meyers FarmChamplin Refg. Company330 Ft. from N. Line       Ft. from S. Line330 Ft. from E. Line       Ft. from W. LineElev. 2086

| Date  | REPORT                                           |
|-------|--------------------------------------------------|
| 1936  |                                                  |
| 11/18 | Location                                         |
| 11/27 | Building rig.                                    |
| 12/3  | Rigging up.                                      |
| 12/10 | Drlg. 110'.                                      |
| 12/17 | Anhydrate 1335'. 10" @ 1342<br>WOC.              |
| 12/24 | Drlg. 2057'.                                     |
| 12/29 | Drlg. 3200'.                                     |
| 1937  |                                                  |
| 1/7   | 7" @ 3594'. Simpson 3611'.<br>T. D. 3625'. RUST. |
| 1/14  | 2900' oil in hole 48 hrs.                        |
| 1/21  | Run tubing.                                      |
|       |                                                  |
| 1/27  | Simpson 3611<br>T. D. 3625<br>Pump 676           |
|       | <u>COMPLETED</u>                                 |
|       |                                                  |
|       |                                                  |
|       |                                                  |

Map No. 71 Sec. 36 Twp. 11 R. 18W

Well No. 1 Meyers

Champlin Ref. Company

Contractor

**SECTION PLAT**

|  |   |  |  |
|--|---|--|--|
|  |   |  |  |
|  |   |  |  |
|  | 0 |  |  |
|  |   |  |  |

330 Ft. from N. Line

\_\_\_\_\_ Ft. from S. Line

330 Ft. from E. Line

\_\_\_\_\_ Ft. from W. Line

**FIRST REPORT**

Location ✓

Rig up \_\_\_\_\_

Drilling and Remarks:

**RECORD**

Cased \_\_\_\_\_ in., \_\_\_\_\_ ft.

Sand \_\_\_\_\_

Gas \_\_\_\_\_

Oil ✓

Total Depth \_\_\_\_\_

**PRODUCTION**

1st 24 hrs. Nat. \_\_\_\_\_

1st 24 hrs. after shot \_\_\_\_\_

Gas \_\_\_\_\_ Cu. Ft.

Dry Hole \_\_\_\_\_

Abandoned \_\_\_\_\_

Date

NOV 18 1936

19

3175WIS


Scout

KANSAS

Map No. 71 Sec. 36 Twp. 11 R. 18WWell No: 1 MeyersChampion Ref. Company

Contractor

## SECTION PLAT

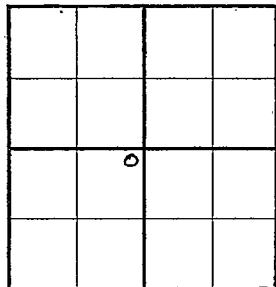330 Ft. from N. Line

\_\_\_\_\_ Ft. from S. Line

330 Ft. from E. Line

\_\_\_\_\_ Ft. from W. Line

COMPLETED

Location \_\_\_\_\_

Rig up \_\_\_\_\_

Drilling and Remarks:

Simpson 3611Pump 676

## RECORD

Cased \_\_\_\_\_ in., \_\_\_\_\_ ft.

Sand \_\_\_\_\_

Gas \_\_\_\_\_

Oil \_\_\_\_\_

Total Depth 3625

## PRODUCTION

1st 24 hrs. Nat. \_\_\_\_\_

1st 24 hrs. after shot \_\_\_\_\_

Gas \_\_\_\_\_ Cu. Ft.

Dry Hole \_\_\_\_\_

Abandoned \_\_\_\_\_

Date

JAN 27 1937 19 \_\_\_\_\_ S. J. LEWIS Scout