


Section 36 Township 11 Range 18-W

Well No. 2 - Meirs "A"

Company Champlin Refg.

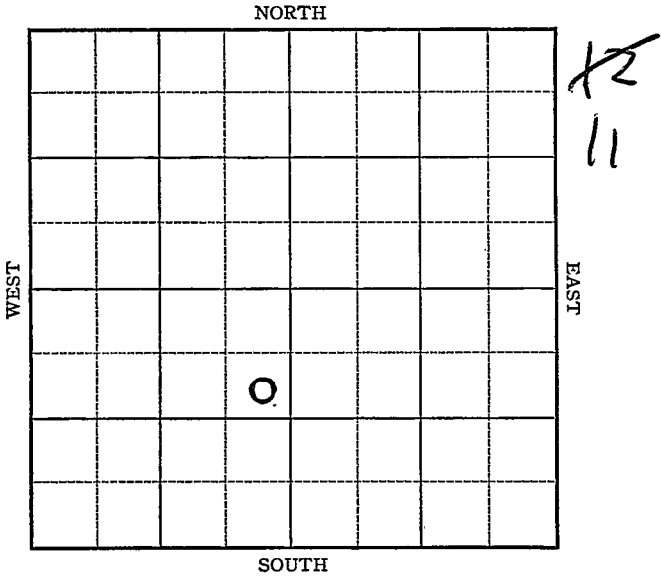

Sec. 36 Twp. 11 R. 18-W

Well No. #2 Meiers "A" Farm

Cahmplin Ref. Company


990 Ft. from N. Line

\_\_\_\_\_ Ft. from S. Line

330 Ft. from E. Line

\_\_\_\_\_ Ft. from W. Line

Elev. 2028

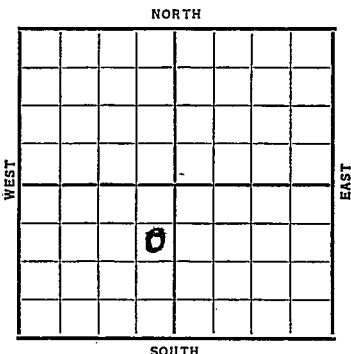

Date	REPORT
<del>1937</del>	
9/8	10" @ 1122'.
	Drlg. 2920'.
9/15	Coring 3569'.
9/24	Sil. & 7" @ 3567'.
	T.D. 3575'. Repair Boiler.
10/2	T.D. 3575'.
	Drilled plug. Filled up 1000'
	oil 20 Min. Total Fill-up
	2800'.
10/7	7" @ 3567'.
	Sil. 3567'.
	T.D. 3575'.
	Pot. 1150 bbls. Nat.
	<b>COMPLETED</b>

Map No. \_\_\_\_\_ Sec. 36 Twp. 11 R. 18W

Well No. 2-Meiers "A"

Champlin Ref Company

Contractor

**FIRST REPORT**

**SECTION PLAT**

990 Ft. from N. Line

\_\_\_\_\_ Ft. from S. Line

330 Ft. from E. Line

\_\_\_\_\_ Ft. from W. Line

	0		

Location \_\_\_\_\_

Rig up \_\_\_\_\_

Drilling and Remarks:

10" 1122

Reg 2920

**RECORD**

Cased \_\_\_\_\_ in., \_\_\_\_\_ ft.

Sand \_\_\_\_\_

Gas \_\_\_\_\_

Oil \_\_\_\_\_

Total Depth \_\_\_\_\_

**PRODUCTION**

1st 24 hrs. Nat. \_\_\_\_\_

1st 24 hrs. after shot \_\_\_\_\_

Gas \_\_\_\_\_ Cu. Ft.

Dry Hole \_\_\_\_\_

Abandoned \_\_\_\_\_

Date

H. D. Hatfield

SEP 8 1927 19

Scout

Ellis KANSAS

Map No. \_\_\_\_\_ Sec. 36 Twp. 11 R. 18W

Well No. 2- Meier "A"

Champlin Company

Contractor

~~COMPLETED~~

SECTION PLAT

SE NE SW

990 Ft. from N. Line

\_\_\_\_\_ Ft. from S. Line

330 Ft. from E. Line

\_\_\_\_\_ Ft. from W. Line

		0	

Location \_\_\_\_\_

Rig up \_\_\_\_\_

Drilling and Remarks:

*POT-1150*

*NAT.*

RECORD

Cased 7 in., 3567 ft.

Sand 511 3567

Gas \_\_\_\_\_

Oil \_\_\_\_\_

Total Depth 3575

PRODUCTION

1st 24 hrs. Nat. \_\_\_\_\_

1st 24 hrs. after shot \_\_\_\_\_

Gas \_\_\_\_\_ Cu. Ft.

Dry Hole \_\_\_\_\_

Abandoned \_\_\_\_\_

Date

OGT - 6 1937

19

H. D. Hatfield

Scout