


Section 36 Township 11 Range 18 W
Well No. # 1 Meier "C"
Company Walters Drlg.

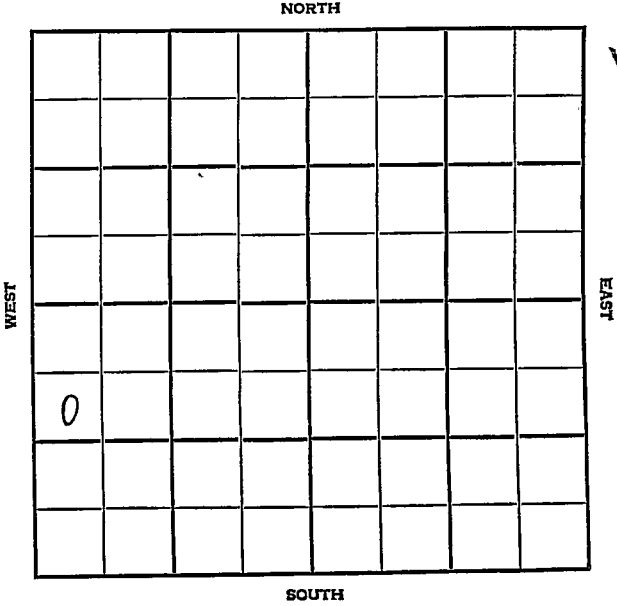

Ellis KANSAS

SEC.	TWP.	R.
36	11	18W

WELL NO.

1 Meier "C"

FARM

COMPANY

Walters Drlg.

CONTRACTOR

Co. Tools

Bemis-Shutts Pool

990


Ft. from N. Line

Ft. from S. Line

Ft. from E. Line

330

Ft. from W. Line

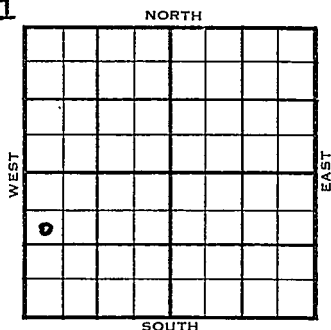

SW NW SW

	ELEVATION	REPORT
1954	1994'	

8/18

Spud 8-14-54
8" @ 166'
Drlg. 1937'

9/1

Spud 8-14-54 D & A TD 3743
8" @ 166' Any 1253' Top. 2588
Heeb 3225 Tor. 3246 Lans 3272
Cong. 3534
DST 3523-46 open $\frac{1}{2}$ hr. rec 5' mud
35# Arb. 3727 TD 3743
D & A

ABANDONED


County Ellis State Kansas
 Sec. 36 (Blk.) 11 (Sur.) 18W Map No.
 Operator Walters Drig.
 Well No. 1 Farm Meier "C"
 Elev. _____ Location SW NW SW

FABEN REPORT									
0									

990 Ft. From N Line SW C.
330 Ft. From W Line Quarter
 1st. Report AUG 18 1954
 Completion _____
 Remarks _____
Co. tools
 Spudding Date 8-14-54

Drig. Data Bemis-Shutts Pool
8" @ 166 drig. 1937

FABEN GILSTRAP

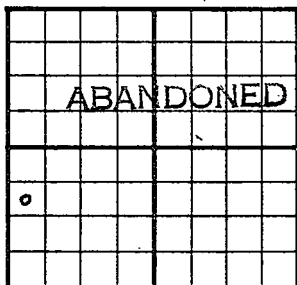County Ellis State KansasSec. 36 (Blk.) 11 (Sur.) 18W Map No.Operator Walters Drlg.Well No. 1 Farm Meier "C"Elev. 1994 Location SW NW SW990 Ft. From N Line SW330 Ft. From W Line Quarter

1st. Report

SEP 1 1954

Completion

Remarks Bemis-Shutts PoolCo. toolsSpudding Date 8-14-54Drlg. Data D & A TD 37438" @ 166 Anhy 1253 Top. 2588Heeb. 3225 Tor. 3246 Lans. 3272Cong. 3 534 DST 3523-46 open $\frac{1}{2}$ hr.Rec. 5' mud 35# Arb. 3727 TD 3743D & A

FABEN GILSTRAP