


Section 36 Township 11 Range 17-W

Well No. 2 Samuelson

Company Cities Service Oil

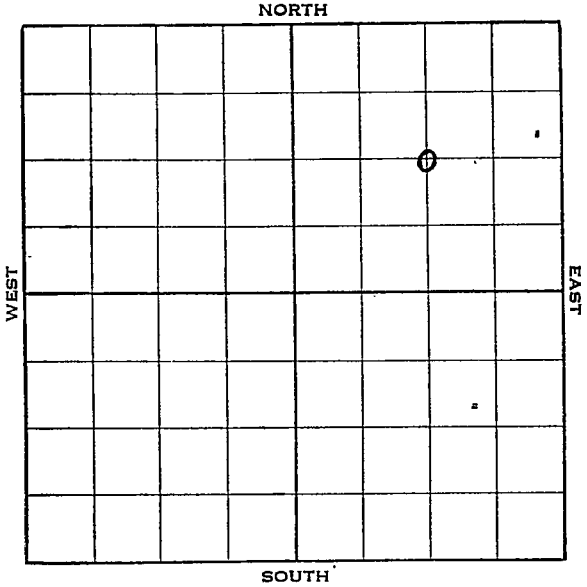



Ellis

Map No. 7/ Sec. 36 Twp. 11 R. 17WWell No. 2 SamuelsonCities Service Oil Company#1 is in sec 31-11-16<sup>0</sup>  
Contractor

## FIRST REPORT

C NE

1320 Ft. from N. Line       Ft. from S. Line1320 Ft. from E. Line       Ft. from W. Line

## SECTION PLAT

		○	

Location XRig up       

Drilling and Remarks:

## RECORD

Cased        in.,        ft.Sand       Gas       Oil       Total Depth       

## PRODUCTION

1st 24 hrs. Nat.       1st 24 hrs. after shot       Gas        Cu. Ft.Dry Hole       Abandoned       

Date

OCT 5 - 1938 19

H. D. Hatfield Scout


Map No. \_\_\_\_\_ Sec. 36 Twp. 11 R. 17WWell No. 2 SamuelsonCities Service Oil Company

Contractor \_\_\_\_\_

ABANDONED

C NE

## SECTION PLAT

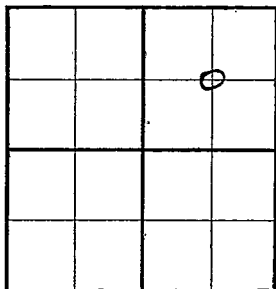1320 Ft. from N. Line

\_\_\_\_\_ Ft. from S. Line

1320 Ft. from E. Line

\_\_\_\_\_ Ft. from W. Line

Location \_\_\_\_\_

Rig up \_\_\_\_\_

Drilling and Remarks:

NO 3471-73DVA

## RECORD

Cased \_\_\_\_\_ in., \_\_\_\_\_ ft.

Sand Arb 3471

Gas \_\_\_\_\_

Oil \_\_\_\_\_

Total Depth 3500

## PRODUCTION

1st 24 hrs. Nat. \_\_\_\_\_

1st 24 hrs. after shot \_\_\_\_\_

Gas \_\_\_\_\_ Cu. Ft.

Dry Hole \_\_\_\_\_

Abandoned \_\_\_\_\_

Date

NOV 9 - 1938

19

H. D. Hatfield Scout