

KANSAS

Ellis


Section 36 Township 11 Range 17W

Well No. 1 Hall "C"

Company Anderson-Prichard

Bemis Pool

NORTH

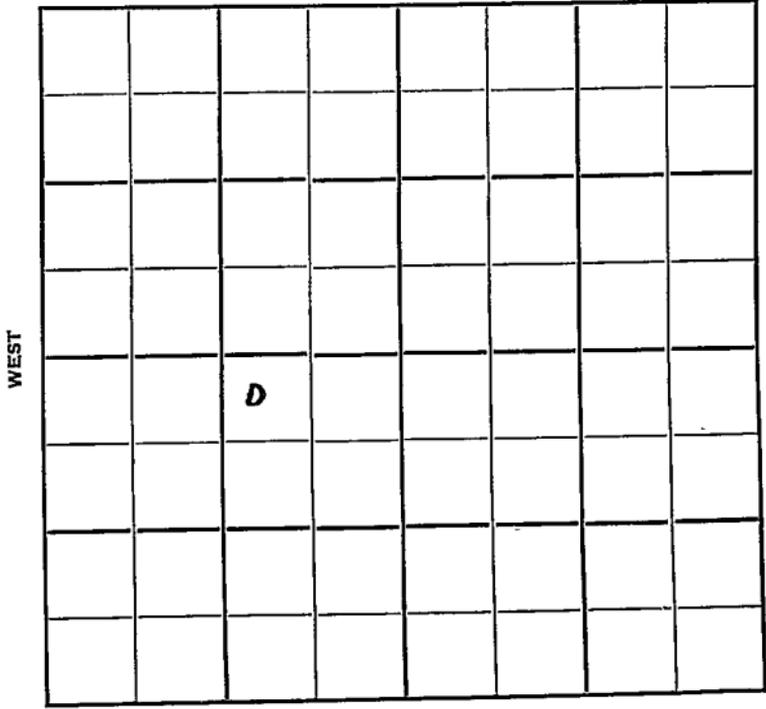

WEST

EAST

SOUTH

Sec. 36 Twp. 11 R. 17W

Well No. #1 Hall "C" Farm _____

Anderson-Prichard Company


Bemis Pool (B & B Drlg., Cont.)

330' Ft. from N. Line

_____ Ft. from S. Line

990' Ft. from E. Line

_____ Ft. from W. Line

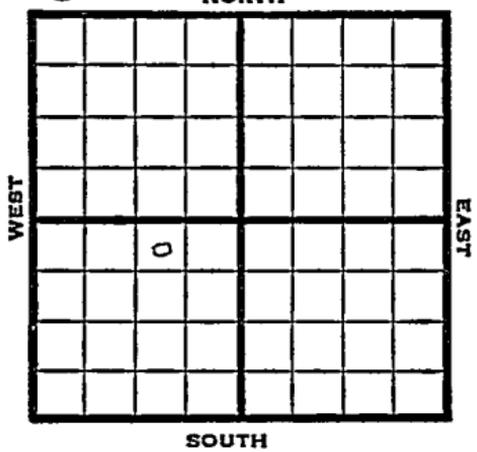

NW NE SW

1949 Elev 2102' REPORT

9/21 RUR
 9/28 13"@ 115'
 Drlg 2750'
 10/5 Lansing 3328'
 Arbuckle 3607'
 TD 3609'
 10/12 5"@ 3608'
 10/19 TD 3621'
 1500 acid
 Swb 3 bbls oil PH 8 hrs.
 10/26 "
 11/1 "
 11/9 "
 11/23 TD 3621'
 Arb. 3607'
 5"@ 3608'
 1500 acid
 Pump 40 Oil Pot
 36° Gr.
 Comp

COMPLETED

Map No. _____ Sec. 36 Twp. 11 R. 17W

Well No. 1 Hall "C"

Anderson-Prichard Company

B & B^t Drlg. Contractor

NW SNE SW

**FIRST REPORT
SECTION PLAT**

330 Ft. from N. Line

_____ Ft. from S. Line

990 Ft. from E. Line

_____ Ft. from W. Line

	o	.	

Ellis County

Location _____

Rig up _____

Drilling and Remarks:

R U R

RECORD

Cased _____ in., _____ ft.

Sand _____

Gas _____

Oil _____

Total Depth _____

PRODUCTION

1st 24 hrs. Nat. _____

1st 24 hrs. after shot _____

Gas _____ Cu. Ft.

Dry Hole _____

Abandoned _____

Date

SEP 21 1949 19

S. J. LEWIS Scout

Kansas

Map No. _____ Sec. 36 Twp. 11 R. 17WWell No. I Hall "C"Anderson-Prichard CompanyCOMPLETE Contractor

NW NE SW

E. 2102
SECTION PLAT330 Ft. from N. Line

_____ Ft. from S. Line

990 Ft. from E. Line

_____ Ft. from W. Line

	6		

Ellis County

Location _____

Rig up _____

Drilling and Remarks:

Cor 36075" C 36081500 acidRun 40 oil test36^o Lr

RECORD

Cased _____ in., _____ ft.

Sand _____

Gas _____

Oil _____

Total Depth 3621

PRODUCTION

1st 24 hrs. Nat. _____

1st 24 hrs. after shot _____

Gas _____ Cu. Ft.

Dry Hole _____

Abandoned _____

Date

NOV 23 1949

19

S. J. LEWIS

Scout