


Section 36 Township 11 Range 17WWell No. #1 Planter StateCompany Brunson Drlg.

NORTH

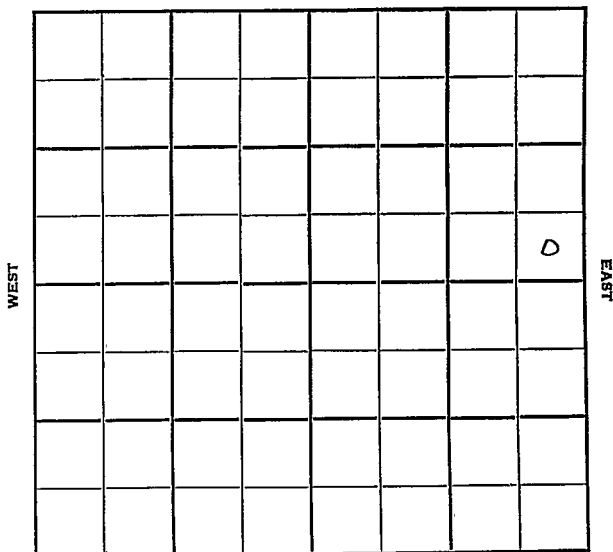

SOUTH

Ellis

KANSAS

Sec. 36 Twp. 11 R. 17 W ✓

Well No. # 1 Planters State Farm

Brunson Drlg.

Company

Brunson Drlg.

Contractor

Bemis Pool

 Ft. from N. Line


330 Ft. from S. Line

330 Ft. from E. Line

 Ft. from W. Line

SE SE NE

Gulf Farmout

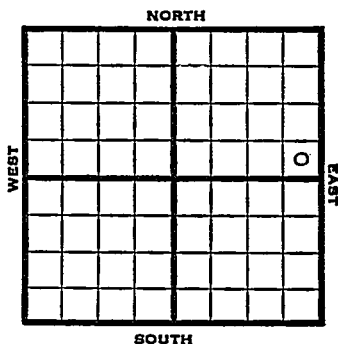

1951 Elev. 1972' REPORT

5/2 Spud 4-27-51
8" @ 108 Anhy 1158'
Drlg. 2145'

5/9 Spud 4-27-51
D & A TD 3551'
8" @ 108 Anhy 1158' Heeb 3150'
Lans. 3198' Cong 3467' Arb. 3514'
TD 3551' D & A

ABANDONED

County Ellis State KansasSec. 36 (Blk. Twp.) 11 (Sur. Rge.) 17W Map No.Operator Brunson Drlg.Well No. 1 Farm Planters StateElev. Location SE SE NE


FIRST REPORT

~~330~~ Ft. From S Line NE
~~330~~ Ft. From E Line Quarter
1st. Report MAY 2 1951

Completion

Remarks Gulf farmoutBrunson Drlg. - Contr.Spudding Date 4-27-51Drlg. Data Bemis Pool8" @ 108 Anhy 1158 orig. 2145

J. E. TYRA

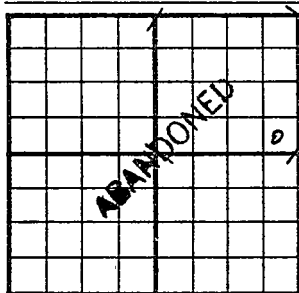County Ellis State KansasSec. 36 (Blk. Twp.) 11 (Sur. Rge.) 17W Map No.Operator Brunson Drlg.Well No. 1 Farm Planters StateElev. 1972 Location SE SE NE330 Ft. From S Line NE330 Ft. From E Line Quarter

1st. Report

Completion MAY 9 1951Remarks Bemis PoolBrunson Drlg. - Contr.Spudding Date 4-27-51Drlg. Data D & A TD 35518" @ 108 Anhy 1158 Heeb. 3150Lans. 3198 Cong. 3467 Arb. 3514TD 3551 D & A

J. E. TYRA