


Section 36 Township 11 Range 19-W

Well No. #1 Jensen

Company Bradley Oil et al

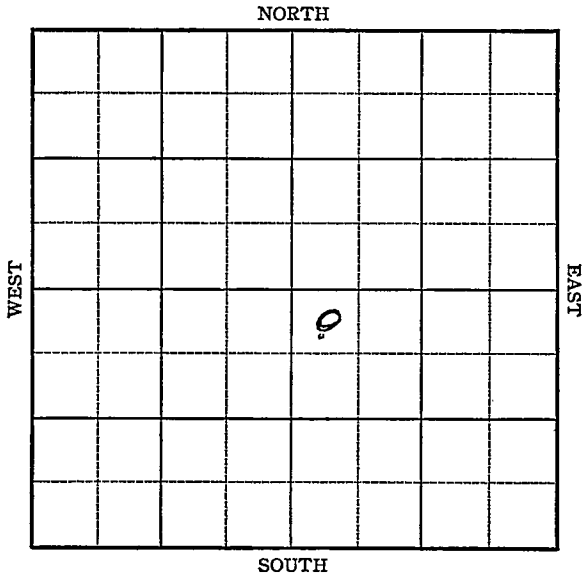

Sec. 36 Twp. 11 R. 19-W

Well No. #1 Jensen Farm

Bradley Oil et al Company


330 Ft. from N. Line

\_\_\_\_\_ Ft. from S. Line

\_\_\_\_\_ Ft. from E. Line

330 Ft. from W. Line

Elev. 2024

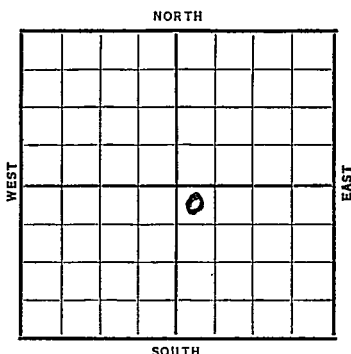

Date	REPORT
1937	
10/27	Location
11/5	R. R.
11/12	"
11/19	13" @ 146'. Anhy 1375'. Drlg. 1665'.
11/26	Drlg. 2735'.
12/3	K.C. 3320'. Stain oil 3383-87'. Drlg. 3405'.
12/10	Cong. 3578'. Simp. 3680'. Sil. 3693'. Cored 3695-3710'. Rec. 5'. Showed sulphur water. Drlg. 3711'.
12/15	Sil. 3693'. T.D. 3780'.
	Sulphur water.
	<b>ABANDONED</b>
	<b>ABANDONED</b>

Ellis

KANSAS

Map No. 70 Sec. 36 Twp. 11 R. 19WWell No. 1 JensenBradley Oil etal Company

Contractor

## FIRST REPORT

## SECTION PLAT

NW SE

330 Ft. from N. Line

\_\_\_\_\_ Ft. from S. Line

\_\_\_\_\_ Ft. from E. Line

330 Ft. from W. Line

		0	

Location X

Rig up \_\_\_\_\_

Drilling and Remarks:

## RECORD

Cased \_\_\_\_\_ in., \_\_\_\_\_ ft.

Sand \_\_\_\_\_

Gas \_\_\_\_\_

Oil \_\_\_\_\_

Total Depth \_\_\_\_\_

## PRODUCTION

1st 24 hrs. Nat. \_\_\_\_\_

1st 24 hrs. after shot \_\_\_\_\_

Gas \_\_\_\_\_ Cu. Ft.

Dry Hole \_\_\_\_\_

Abandoned \_\_\_\_\_

Date

OCT 27 1937H. D. Hatfield

Scout

Map No. 70 Sec. 36 Twp. 11 R. 19W

Well No. 1 Jensen

Bradley Oil etal Company

Contractor

**ABANDONED**

**SECTION PLAT**

330 <sup>NW SE</sup> Ft. from N. Line

\_\_\_\_\_ Ft. from S. Line

\_\_\_\_\_ Ft. from E. Line

330 Ft. from W. Line

		0	

Location \_\_\_\_\_

Rig up \_\_\_\_\_

Drilling and Remarks:

*Sulphur water*

*DVA*

**RECORD**

Cased \_\_\_\_\_ in., \_\_\_\_\_ ft.

Sand *511 3693*

Gas \_\_\_\_\_

Oil \_\_\_\_\_

Total Depth *3780*

**PRODUCTION**

1st 24 hrs. Nat. \_\_\_\_\_

1st 24 hrs. after shot \_\_\_\_\_

Gas \_\_\_\_\_ Cu. Ft.

Dry Hole \_\_\_\_\_

Abandoned \_\_\_\_\_

Date

DEC 15 1937 19

H. D. Hatfield Scout