

KANSAS


FORM 51 IOM 12-46 PETROL

Trego county

Section 36 Township 11 Range 21-W

Well No. #1, Dietrich

Company Palmer Oil Company

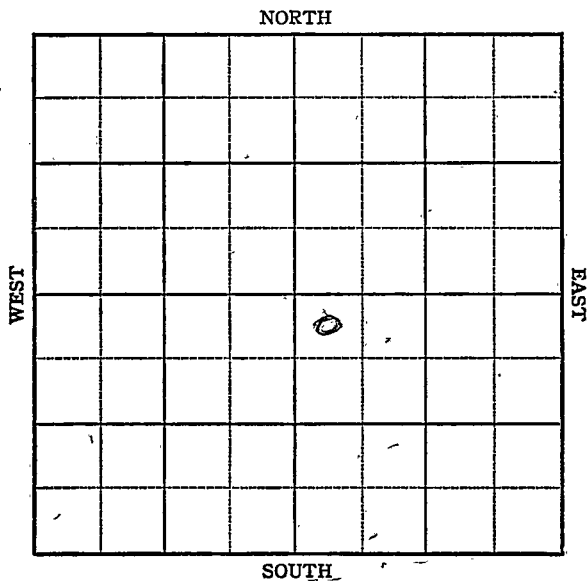

KANSAS

Trego county

Sec. 36 Twp. 11 R. 21-W

Well No. #1, Dietrich Farm

Palmer Oil Company Company


Wildcat

330' Ft. from N. Line

Ft. from S. Line

Ft. from E. Line

330' Ft. from W. Line

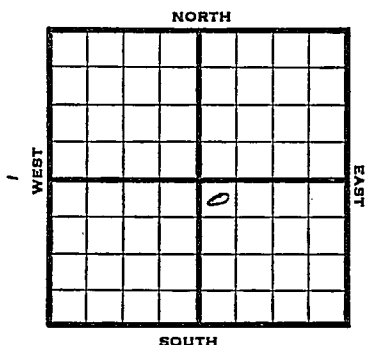

NW SE

1946

Elev. 2283' REPORT

12/11

8" @ 220'

Drlg. 1500'

12/17

Drlg 3400'

1947

1/2

Lans 3595'

Cong 3960'

Arb 3964'

TD 4000'

**ABANDONED**

Map No. 70 Sec. 36 Twp. 11 R. 21W

Well No. 1 Dietrich

Palmer Oil Company

**FIRST REPORT** Contractor

NW SE


SECTION PLAT

330 Ft. from N. Line

       Ft. from S. Line

       Ft. from E. Line

330 Ft. from W. Line

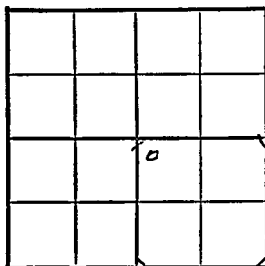

Trego County

Location                     

Rig up                     

Drilling and Remarks:

8" @ 220

drlg. 1500

RECORD

Cased        in.,        ft.

Sand                     

Gas                     

Oil                     

Total Depth                     

PRODUCTION

1st 24 hrs. Nat.                     

1st 24 hrs. after shot                     

Gas                      Cu. Ft.

Dry Hole                     

Abandoned                     

Date

DEC 1 1 1946 . 19

S. J. LEWIS Scout

Map No. 70 Sec. 36 Twp. 11 R. 21W

Well No. 1 Dietrich

Palmer Oil

Company

**ABANDONED**

Contractor

NW SE


E/ 2283  
SECTION PLAT

330 Ft. from N. Line

\_\_\_\_\_ Ft. from S. Line

\_\_\_\_\_ Ft. from E. Line

330 Ft. from W. Line

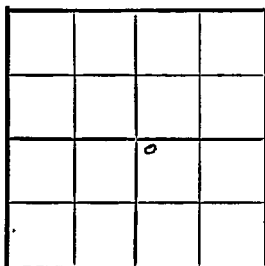

Trego County

**RECORD**

Location \_\_\_\_\_

Cased \_\_\_\_\_ in., \_\_\_\_\_ ft.

Rig up \_\_\_\_\_

Sand \_\_\_\_\_

Drilling and Remarks:

Gas \_\_\_\_\_

Lans 3595

Oil \_\_\_\_\_

Comp 8960

Total Depth 4000

Comp 8964

**PRODUCTION**

1st 24 hrs. Nat. \_\_\_\_\_

1st 24 hrs. after shot \_\_\_\_\_

Gas \_\_\_\_\_

Cu. Ft. \_\_\_\_\_

Dry Hole \_\_\_\_\_

Abandoned \_\_\_\_\_

Date

JAN 2 1947

19

S. J. LEWIS

Scout