

KANSAS

Form 51—5M—7-39—Palace

Ellis

Section 4 Township 11 Range 17-W

Well No. #1 Stone


Company Dickey Oil

Bemis Pool

NORTH

WEST

EAST

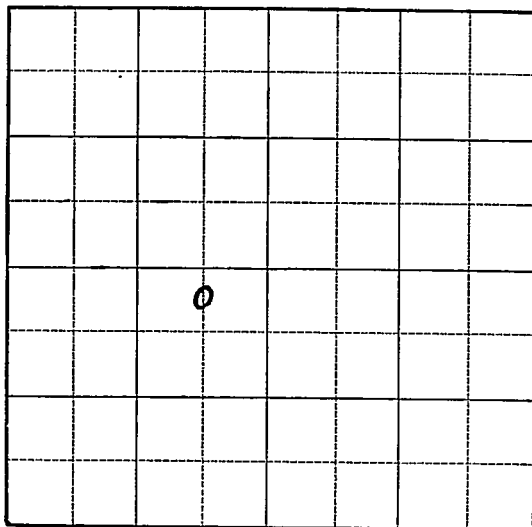

SOUTH

11


KANSAS

Ellis

Sec. 4 Twp. 11 R. 17-WWell No. #1 Stone FarmBickey Oil

Company

(Bemis)

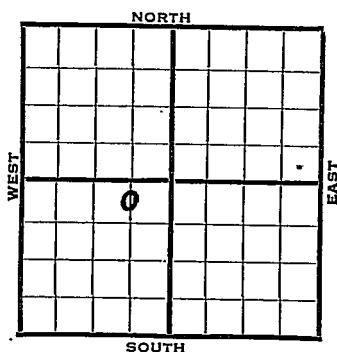330 Ft. from N. Line Ft. from S. Line660 Ft. from E. Line Ft. from W. Line

Elev. 1938

1940

REPORT

3/20

Rotary.

3/28

"

4/4

15" - 58' WOC.

4/12

" " "

4/18

Drlg. 3265'

4/24

Arb. 3528' water.

T.D. 3533'

ABANDONED

Map No. 71 Sec. 4 Twp. 11 R. 17WWell No. 1 StoneDickey Oil

Company

Contractor

FIRST REPORT

C N L NE SW

330 Ft. from N. Line Ft. from S. Line660 Ft. from E. Line Ft. from W. Line

BEMIS POOL

SECTION PLAT

	o		

Location Rig up

Drilling and Remarks:

Rotary

RECORD

Cased in., ft.Sand Gas Oil Total Depth

PRODUCTION

1st 24 hrs. Nat. 1st 24 hrs. after shot Gas Cu. Ft.Dry Hole Abandoned

Date

MAR 20 1940

19

S. J. LEWIS

Scout

Map No. 71 Sec. 4 Twp. 11 R. 17WWell No. 1 StoneDickey Oil

Company

Contractor

ABANDONED

SECTION PLAT

C N L NE SW

330 Ft. from N. Line

Ft. from S. Line

660 Ft. from E. Line

Ft. from W. Line

BEMIS POOL

	o		

Location _____

Rig up _____

Drilling and Remarks:

*CR & 3528**Wated.*

RECORD

Cased _____ in., _____ ft.

Sand _____

Gas _____

Oil _____

Total Depth 3533

PRODUCTION

1st 24 hrs. Nat. _____

1st 24 hrs. after shot _____

Gas _____ Cu. Ft.

Dry Hole _____

Abandoned _____

Date

APR 24 1940 19S. J. LEWIS Scout