


Section 4 Township 11 Range 15W
 Well No. #1 Worley
 Company B & B Drlg.

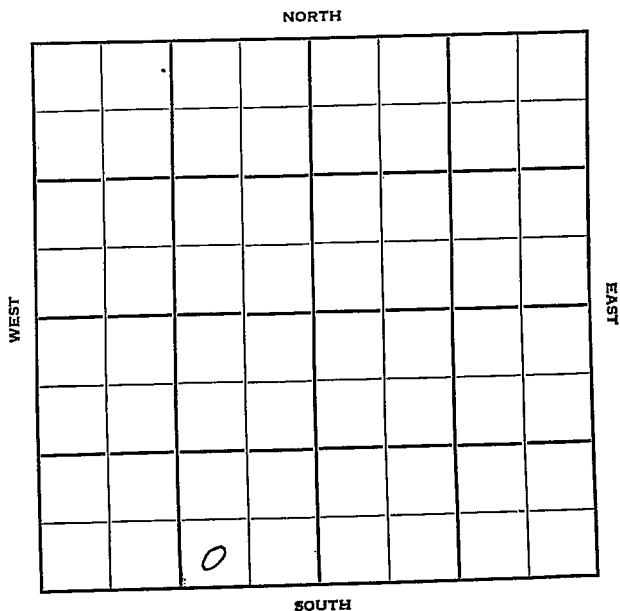

Russell

KANSAS

Sec. 4 Twp. 11 R. 15W

Well No. #1 Worley Farm

B & R Drlg. Company

Wildcat Contractor


 Ft. from N. Line

330' Ft. from S. Line

990' Ft. from E. Line

 Ft. from W. Line

SW SE SW

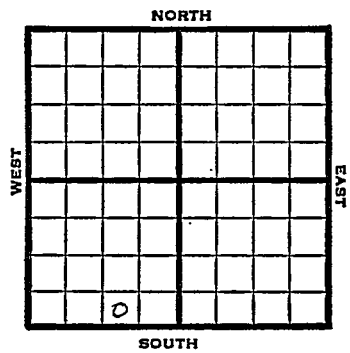

1950	Elev 1907' REPORT
1/25	8" @ 185' Drlg. 2200'
2/15	TD 3410' 8"@ 185' 5"@ 3372' Anhy 990' Heeb 2987' Lans 3047' Arb. 3371' D&A Aband. ABANDONED

Kansas

Wildcat


Map No. _____ Sec. 4 Twp. 11 R. 15WWell No. 1 Worley

_____ B & B Drllr. _____ Company

_____ Contractor

SW SE SW

SECTION PLAT

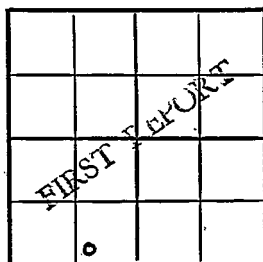

_____ Ft. from N. Line

330 Ft. from S. Line990 Ft. from E. Line

_____ Ft. from W. Line

Russell County

Location _____

Rig up _____

Drilling and Remarks:

8" @ 185

drlg. 2200

RECORD

Cased _____ in., _____ ft.

Sand _____

Gas _____

Oil _____

Total Depth _____

PRODUCTION

1st 24 hrs. Nat. _____

1st 24 hrs. after shot _____

Gas _____ Cu. Ft.

Dry Hole _____

Abandoned _____

Date

JAN 25 1930
JAN 22 1930 19

J. E. TYRA

Scout

Kansas

Map No. _____ Sec. 4 Twp. 11 R. 15WWell No. 1 Worley "C"


_____ B & B Drlg. _____ Company

_____ Contractor

SW SE SW

E. 1907

SECTION PLAT

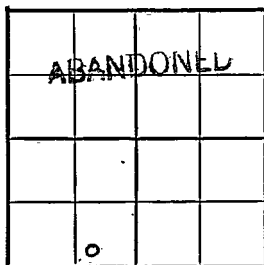

_____ Ft. from N. Line

330 Ft. from S. Line990 Ft. from E. Line

_____ Ft. from W. Line

Russell County

Location _____

Rig up _____

Drilling and Remarks:

8" @ 1855" @ 3372and 990Hub 2987Lans 3047and 3371D + A.

RECORD

Cased _____ in., _____ ft.

Sand _____

Gas _____

Oil _____

Total Depth 3410

PRODUCTION

1st 24 hrs. Nat. _____

1st 24 hrs. after shot _____

Gas _____ Cu. Ft.

Dry Hole _____

Abandoned _____

Date

FEB 15 1950

19

J. E. TYRA

Scout