


Section 4 Township 11 Range 12-W

Well No. #1, Steinle

Company Dutton and Briggs

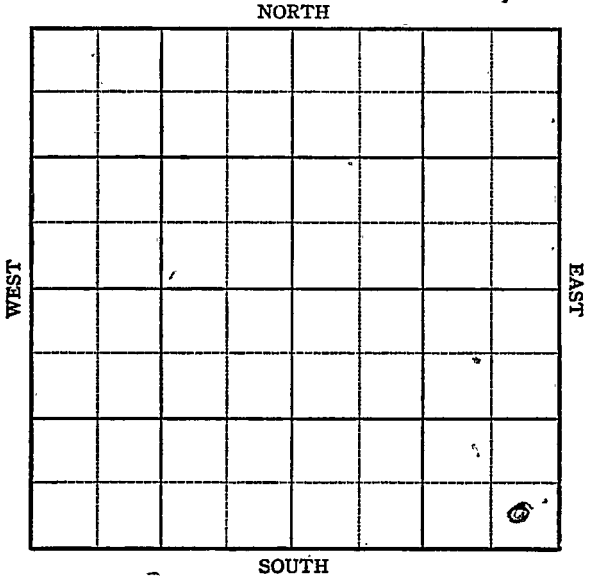

KANSAS

Russell county

Sec. 4 Twp. 11 R. 12-W

Well No. #1, Steinle Farm

Dutton and Briggs Company


Fairport Pool

_____ Ft. from N. Line

330' Ft. from S. Line

330' Ft. from E. Line

_____ Ft. from W. Line

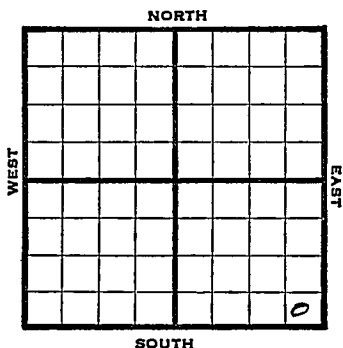

SE/C

1946 Elev. 1698' REPORT

12/18 Location

1947

1/4 Location

1/8 "

1/15 "

1/21 "

1/30 "

2/5 "

2/12 "

2/19 "

2/26 "

3/4 Rig

3/11 "

3/18 RUR

3/25 "

OVER

4/2 BUR
 4/9 "
 4/15 Anhydrite 706
 Drlg. 881'
 4/23 10" @ 66
 1805 fsg
 4/29 Dodge 2680'
 Drlg. 2704'
 5/7 Topeka 2540
 Lans 2938 -
 SSO 3954-66
 TD 3085'
 Run 7"
 5/13 7" @ 3073'
 RUST
 5/20 " "
 5/27 " "
 6/3 " "
 6/10 " "
 6/21 " "
 6/24 " "
 7/1 Drilling cement
 7/8 TD 3103
 Water
 7-16 TD 3142
 HFW
 7/22 " .
 7/30 Lans. 2910'
 7" @ 3073'
 TD 3142'

ABANDONED

Map No. _____ Sec. 4 Twp. 11 R. 12W

Well No. 1 Steinle

Dutton & Briggs Company

FIRST REPORT

Contractor

SE/C

SECTION PLAT

			6

_____ Ft. from N. Line

330 Ft. from S. Line

330 Ft. from E. Line

_____ Ft. from W. Line

Russell County

Location X

Rig up _____

Drilling and Remarks:

RECORD

Cased _____ in. _____ ft.

Sand _____

Gas _____

Oil _____

Total Depth _____

PRODUCTION

1st 24 hrs. Nat. _____

1st 24 hrs. after shot _____

Gas _____ Cu. Ft.

Dry Hole _____

Abandoned _____

Date

DEC 1 8 1946 19

S. J. LEWIS Scout

Map No. 56 ^{Kansas} Sec. 4 Twp. 11 R. 12WWell No. 1 SteinleDutton & Hicks

Company

ABANDONED

Contractor

SE/C

E 11698
SECTION PLAT Ft. from N. Line330 Ft. from S. Line330 Ft. from E. Line Ft. from W. Line

Russell County

RECORD

Location _____

Cased _____ in., _____ ft.

Rig up _____

Sand _____

Drilling and Remarks:

Gas _____

Oil _____

Total Depth 8142

PRODUCTION

1st 24 hrs. Nat. _____

1st 24 hrs. after shot _____

Gas _____ Cu. Ft.

Dry Hole _____

Abandoned _____

Date

JUL 30 194719S. J. LEWIS

Scout