


Section 4 Township 11 Range 18W

Well No. #1 Warner

Company Oil Producing Inc.

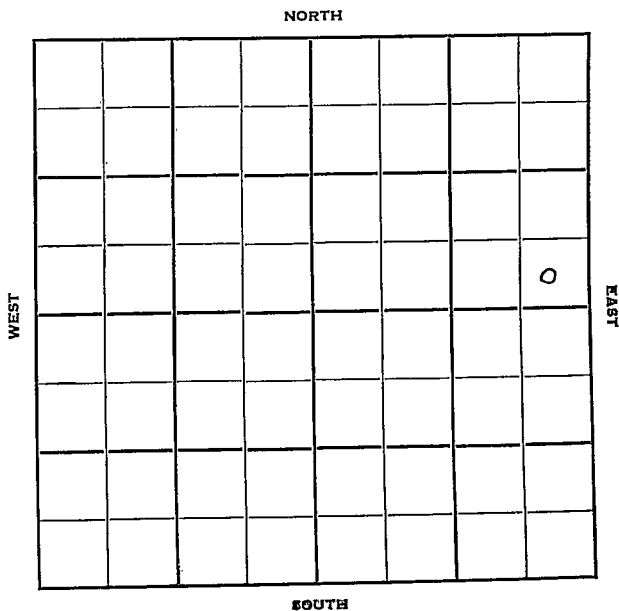

8

Ellis

KANSAS ✓

Sec. 4 Twp. 11 R. 18 W

Well No. # 1 Warner Farm

Oil Producing Inc. Company

Murfin Drlg. Contractor

Meistrell Pool

 Ft. from N. Line


330 Ft. from S. Line

330 Ft. from E. Line

 Ft. from W. Line

SE SE NE

NCRA - DHM

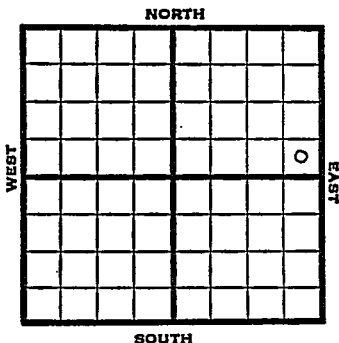

1951

Elev. - REPORT

8/15

8" @ 125'

8/29

Spud 8-13-51

D&A TD 3560

8" @ 125

Heeb. 3140 Lans. 3182

DST 3185-3226 opn 25 min.


Rec. 30' mud

DST 3245-70 opn 1/2 hr Rec. 25' mud

Arb. 3524-60 TD

D&A

ABANDONED

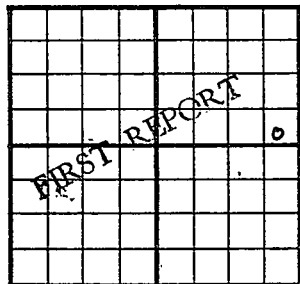County Ellis State KansasSec. 4 (Blk.) 11 (Sur.) 18W Map No.Operator Oil Producing Inc.Well No. 1 Farm WarnerElev. Location SE SE NE330 Ft. From S Line NE330 Ft. From E Line Quarter1st. Report AUG 15 1951

Completion


Remarks NCRA • DHMMurfin Drlg.

Spudding Date

Drlg. Data Weistrell Pool8" @ 125

J. E. TYRA

County Ellis State Kansas
 Sec. 4 (Blk.) 11 (Sur.) 18W Map No. _____
 Operator Oil Producing Inc.
 Well No. 1 Farm Warner
 Elev. _____ Location SE SE NE

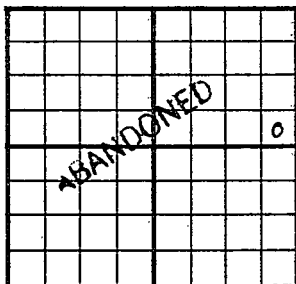

330 Ft. From S Line NE
330 Ft. From E Line Quarter
 Ist. Report _____
 Completion AUG 29 1951
 Remarks Meistrell Pool
Murfin Drlg. - Contr.
 Spudding Date 8-13-51

Drlg. Data D & A TD 3560
8" @ 125 Heeb. 3140 Lans. 3182
DST 3185-3226 open 25. min. Rec. 30' mud
DST 3245-70 open $\frac{1}{2}$ hr. Rec. 25' mud
Arb. 3524-60 TD.

D & A

J. E. TYRA