

Ellis County


FORM 51 10M 8-47

KANSAS

Section 4 Township 11 Range 20N

Well No. 1 Beach

Company Sohio & Continental

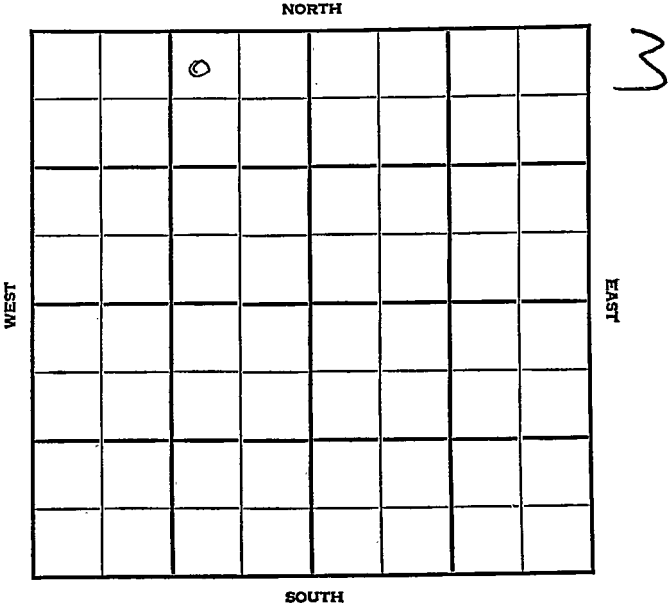

HOT KANSAS ELLIS FILE ✓

Sec. 4 Twp. 11 R. 20W

Well No. #1 Beach Farm

Sohio & Continental Company

Wildcat


330 Ft. from N. Line

Ft. from S. Line

990 Ft. from E. Line

Ft. from W. Line

NW NE NW

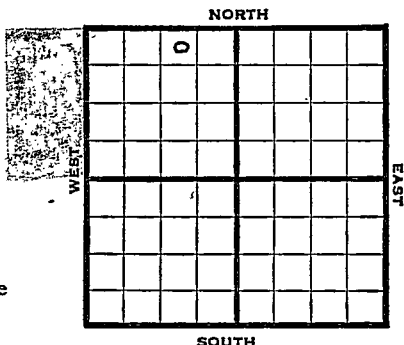

1947

Elev. 2148' REPORT

12/30

Location

1948

1/7

13" @ 233'

WOC

1/14

Drlg 3340'

1/21

Lans. 3449'

Cong. 3721'

Arb. 3799'

TD 3844'

ABANDONED

Map No. _____ Sec. 4 Twp. 11 R. 20W

Well No. 1 Beach


Sohio & Continental Company

FIRST REPORT

Contractor

NW NE NW

SECTION PLAT

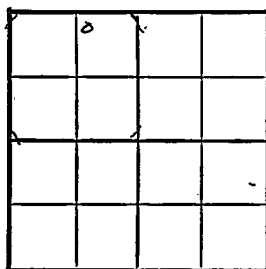

330 Ft. from N. Line

_____ Ft. from S. Line

990 Ft. from E. Line

_____ Ft. from W. Line

Ellis County

Location X

Rig up _____

Drilling and Remarks:

RECORD

Cased _____ in., _____ ft.

Sand _____

Gas _____

Oil _____

Total Depth _____

PRODUCTION

1st 24 hrs. Nat. _____

1st 24 hrs. after shot _____

Gas _____ Cu. Ft.

Dry Hole _____

Abandoned _____

Date

DEC 30 1947 19

S. J. LEWIS

Scout

Map No. 70 Sec. 4 Twp. 11 R. 20^W

Well No. 1 Beach

Sohio & Continental Company

ABANDONED

Contractor

NW NE NW

E12148
SECTION PLAT

330 Ft. from N. Line

_____ Ft. from S. Line

990 Ft. from E. Line

_____ Ft. from W. Line

	0		

Ellis County

Location _____

Rig up _____

Drilling and Remarks:

Lane 3449
Comp 3221
Cr 3799

RECORD

Cased _____ in., _____ ft.

Sand _____

Gas _____

Oil _____

Total Depth 3844

PRODUCTION

1st 24 hrs. Nat. _____

1st 24 hrs. after shot _____

Gas _____ Cu. Ft.

Dry Hole _____

Abandoned _____

Date

JAN 21 1948

19

S. J. LEWIS

Scout