

Section 4 Township 11 Range 23 WWell No. # 1 OsbornCompany Imperial Pet.

		0						

NORTH

WEST


EAST

SOUTH

6

Sec. 4 Twp. 11 R. 23WWell No. #1 Osborn FarmImperial Petr. CompanyImperial Contractor Ft. from N. Line330 Ft. from S. Line990 Ft. from E. Line Ft. from W. Line

SW SE NW

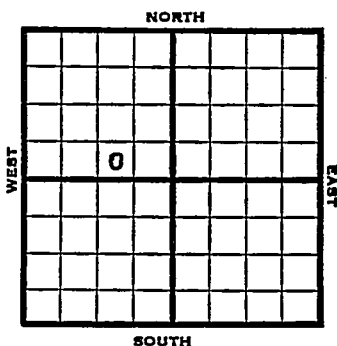

1953

Elev. 2303'

REPORT

8/5

Spud 7-28-53

8" @ 190

Drlg. 3203'

8/12

Anhy 1780 Heeb 3500 Lans 3536

DST 3562-79, 1 hr, 2333' GCO 1160#

DST 3693-3711, 1 hr, 30' OCM, 160#

RTD 3740 5" @ 3740

8/19

DD 3753' NS Elec log Plug 3600'

37/3575-80 S/20 BOPH SI 8 hrs.

FU 3100' oil 5000 A S/48 BOPH

POP

8/26

N.R.

9/4

Spud 7-28-53

Oil Well

TD 3753

8" @ 190

Anhy 1780, Heeb 3500, Lans 3536

DST 3562-79, opn 1 hr., rec. 2333'

gco, 1160#

DST 3693-3711, opn 1 hr., rec. 30'

ocm, 160#

TD 3740

5", @ 3740

DST 3716-31, opn 3/4 hrs., rec. 6'

mud, DD 3753, SP 3600, 37/3575-80,

S/20 boph shut in 8 hrs., FU 3100'

oil, 5000A, S/48 boph

Comp. 3000 bopd

COMPLETED

County **Trego** State **Kansas**

Sec. 4 (Blk. II) (Sur. 23W) Map No. _____
(Twp.) (Rge.)

Operator Imperial Pet.

Well No. 1 Farm Osborn

Elev.	Location	SW	SE	NW
-------	----------	----	----	----

0

FIRST REPORT

330 Ft. From S Line NFF

990 Ft. From E Line Quarter

1st. Report **AUG 5 1953**

Completion

Remarks _____

Imperial - Contr.

Spudding Date 7-28-53

Drlg. Data

8th @ 190 drlg. 3203

J. G. McGEHEE

County Trego State Kansas

Sec. 4 (Blk. Twp.) 11 (Sur. Rge.) 23^W Map No.

Operator Imperial Pet.

Well No. 1 Farm Osborn

Elev.	2303	Location	SW SE NW
-------	------	----------	----------

0

COMPLETE

330Ft. From S Line NW

990Ft. From F Line Quarter

1st. Report

Completion SEP 2 1953

Remarks

Imperial - Contr.

Spudding Date 7-28-53

Drilg. Data	Oil well	TD 3753
-------------	----------	---------

8" @ 190 Anh'y 1780 Heeb. 3500

Lans. 3536 DST 3562-79 open 1 hr.

Rec. 2333' geo 1160# DST 3693-3711

open 1 hr. Rec. 30' ocm 160#

TD 3740 5" @ 3740 DST 3716-31

open 3/4 hr. Rec. 6' mud DD 3753

SP 3600 37/ 3575-80 S/ 20 boph

shut in 8 hr. FU 3100' oil 5000 A

S/ 48 boph Comp. 3000 bopd