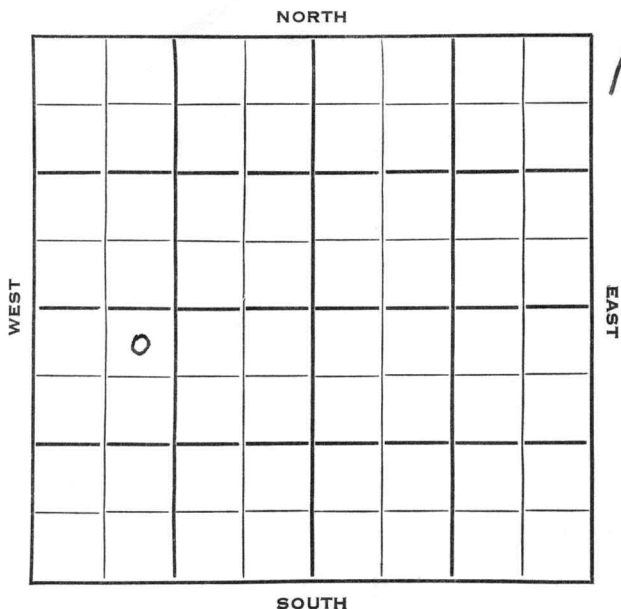


Trego

KANSAS

Section 4 Township 11 Range 23WWell No. 1 I. L. WalkerCompany Skelly Oil

Trego

KANSAS

SEC.	TWP.	R.
4	11	23W

WELL NO.

#1 I.L. Walker

FARM

COMPANY

Skelly Oil

CONTRACTOR

Wentworth

Walker Pool

330

Ft. from N. Line


Ft. from S. Line

Ft. from E. Line

990

Ft. from W. Line

NE NW SW

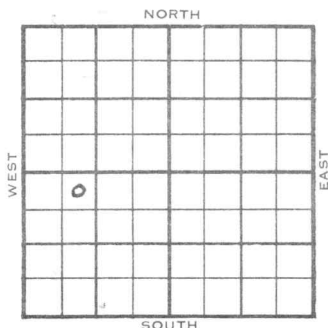

1953

ELEVATION

2306'

REPORT

9/16

Spud 9-11-53

8" @ 394'

Drlgl305'

9/23

Heeb 3509, Tor 3531, Lans 3546

DST 3539-53, 1 hr., 300' wtr, 1035#

Drlg.

9/30

5" set

10/28

Spud 9-11-53

D&A

TD 4050'

8" @ 394'

Heeb 3509, Tor 3531, Lans 3546

DST 3539-53, opn 1 hr., rec. 300' wtr. 1035#

DST 3572-94, opn 1 hr., rec. 285'

wtr. & SSO & G, 1260' hocw, 5% oil 360' sw, 1265#

DST 3703-15, opn 1/2 hrs., rec. 5' ocm,

DST 3721-35, opn 1/2 hrs., rec. 4 1/2' mud

~~DST 3721-35, opn 1/2 hrs., rec. 4 1/2' mud~~

DST 3748-58, opn 1 hr., rec. 20' ocm, 340#

Marm 3886, Cong 3970', Arb. 4022'

TD 4050'

OVER

(Information Brought Forward)

1953

10/28

5" @ 4050'

CO to 3986

16/3748-50, 500A

B/8 **goph**, 1500A 8 go 2 gwph 6 hrs.

PB 3736

41/3722-27, 500A dry

PB 3700

16/3688-90, 500A

S/6 bwph 4 hrs.

PB 3650

24/3638-41, 500A

S/4 bwph 4 hrs.

PB 3600

50/3581-86, 500A 17 bfph 2 hrs.

90% wtr.

CO to 3595, 30/3581-84, 300A

S/15 bo 351 bw 18 hrs.

PB 3565

50/3537-42, 500A

S/4/4 bo 36 bw 4 hrs.

D&A

ABANDONED


County Trego State Kansas

Sec. 4 (Blk. Twp.) 11 (Sur. Rge.) 23W Map No.

Operator Skelly Oil

Well No. 1 Farm I. L. Walker

Elev. 2306 Location NE NW SW

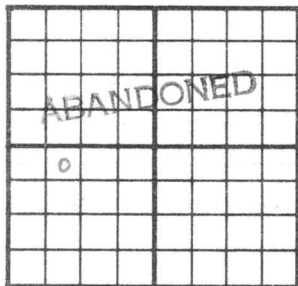

330 Ft. From N Line SW

990 Ft. From W Line Quarter

1st. Report

Completion OCT 28 1953

Remarks Walker Pool

Wentworth - Contr.

Spudding Date 9-11-53

Drlg. Data D & A TD 4050

8" @ 394 Heeb. 3509 Tor. 3531

Lens. 3546 DST 3539-53 open 1 hr.

Rec. 300' wtr. 1035# DST 3572-94

open 1 hr. Rec. 285' wtr. & SSO & G

1260' hocw 5% oil 360' sw 1265#

DST 3703-15 open $\frac{1}{2}$ hr. Rec. 5' ocmDST 3721-35 open $\frac{1}{2}$ hr. Rec. $4\frac{1}{2}$ ' mud

DST 3748-58 open 1 hr. Rec. 20' ocm

340# Marm. 3886 Cong. 3970

Arb. 4022 TD 4050 5" @ 4050 CO to

3986 16/ 3748-50 500 A B/ 8 goph

1500 A 8 go 2 gwph 6 hr. PB 3736

41/ 3722-27 500 A dry PB 3700

16/ 3688-90 500 A S/ 6 bwph 4 hr.

J. G. McGEHEE

Drlg. Data

PB 3650 24/ 3638-41 500 A 6/4 bwph


4 hr. PB 3600 50/ 3581-86 300 A

17 bfph 2 hr. 90% wtr. 60 to 3595

30/ 3581-84 300 A S/ 15 351 bw

18 hr. PB 3565 50/ 3537-42 500 A

S/ $\frac{1}{4}$ bo 36 by 4 hr.

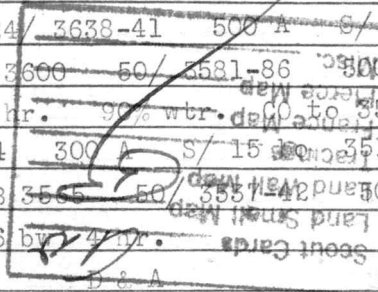

NOV 2 1953