


Section 4 Township 11 Range 23W

Well No. 3 Osborne

Company Imperial Drlg.

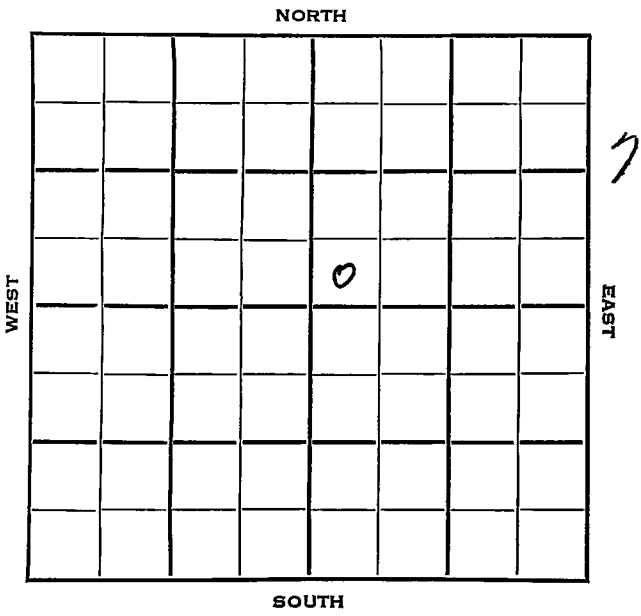

Trego

KANSAS

SEC.	TWP.	R.
4	11	23W

WELL NO.

#3 Osborne

FARM

COMPANY

Imperial Drlg.

CONTRACTOR

Wakeeney Pool

NORTH

Ft. from N. Line


330 Ft. from S. Line

Ft. from E. Line

330 Ft. from W. Line

WEST

EAST

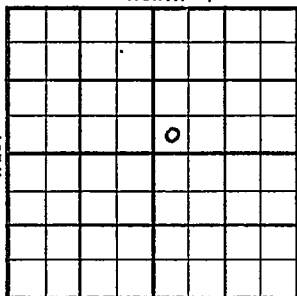

SOUTH

SW SW NE

	ELEVATION	REPORT
1954	2301'	

1/20 Spud 1-19-54
8" @ 222'

WOC

1/27 Anhy 1776'
Drlg. 3375'

2/3 Spud 1-19-54 D & A TD 4011
8" @ 222 Anhy 1776 Heeb 3509
Lans. 3544 Marm. 3885 Cong. 3968
TD 4011 D & A

ABANDONED

County **Trego** State **Kansas**

Sec. 4 (Blk. 11 (Sur. 23W (Twp. Map No.

Operator **Imperial Drlg.**

Well No. 3 Farm Osborne

Elev.	Location	SW	SW	NE
-------	----------	----	----	----

0

FIRST REPORT

530 Ft. From S Line NE

330 Ft. From W Line Quarter

1st. Report JAN 20 1954

Completion


Remarks

Spudding Date **1-19-54**

Drig. Data Wakeeney Pool

8th @ 222 WOC

County Trego State Kansas
 Sec. 4 (Blk. 11 (Sur. 23W Map No.
 (Twp.) (Rge.)
 Operator Imperial Drlg.
 Well No. 3 Farm Osborne
 Elev. 2301 Location SW SW NE

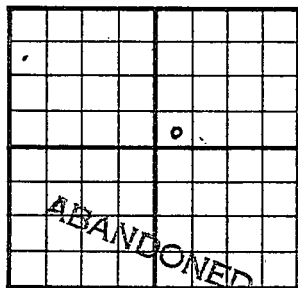

330 Ft. From S Line NE
330 Ft. From W Line Quarter
 1st. Report FEB 3 1954
 Completion
 Remarks Wakeeney Pool

Spudding Date 1-19-54

Drlg. Data D & A TD 4011

8" @ 222 Anhy 1776 Heeb. 3509

Lans. 3544 Marm. 3885 Cong. 3968

TD 4011

D & A