


Trego KANSAS

SECTION 4 TOWNSHIP 11 RANGE 23W

WELL NO. #3 Surmeir

COMPANY Imperial Oil

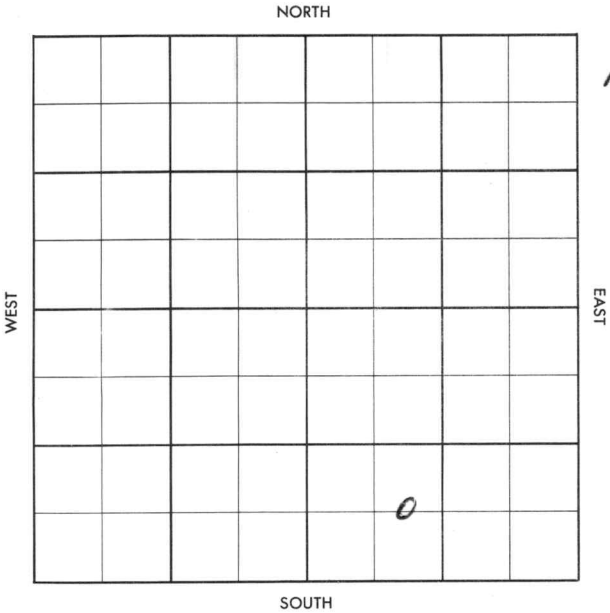

#18 Trego

KANSAS

|           |            |           |
|-----------|------------|-----------|
| SEC.<br>4 | TWP.<br>11 | R.<br>23W |
|-----------|------------|-----------|

WELL NO.

#3 Surmeir

FARM

COMPANY

Imperial Oil

CONTRACTOR

Co. Tools


Diebolt

Ft. from N. Line

Ft. from S. Line

Ft. from E. Line

Ft. from W. Line

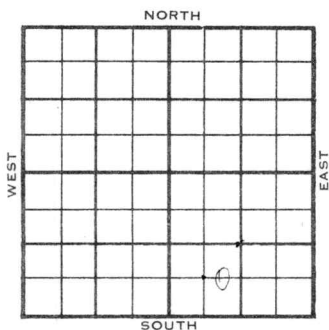C E  $\frac{1}{2}$  SW SE

1956

ELEVATION

2291

REPORT

4-11

Comm. 4-8-56

8" @ 193

Drlg. 1800

Anh. 1768

4-25

DST 3494-3503, op 30 min. rec. 559' SW,

BHP 1250#

DST 3572-84 op 1 hr. rec. 30' wtr.

BHP 510#.

DST 3598-3623 op 1 hr. rec. 5' mud,

BHP 0#

DST 3626-40 op 2 hrs., rec 450' SW,

BHP 725#

DST 3696-3770' op 30 min. rec. 5' mud,

BHP 35#

D &amp; A

H. 3508

L. 3543

TD 3770'

ABANDONED

|                      |            |      |
|----------------------|------------|------|
| Date Comm.           | 4-8-56     | Sec. |
| 8 <sup>n</sup> @ 193 | drlg. 1800 |      |

APR 1 7 1956

19. 20.

Co.

Loc.

No.

Sec.

T.

R.

County

Trego

Elev.

2291

Sec.

4

Twp.

11

Rge.

23W

Company

Imperial Oil

Farm Name

Summeir

No.

3

| TOPS   | DEPTH | LOG | DATUM | Loc. in Sec. |
|--------|-------|-----|-------|--------------|
| Anh.   | 1768  |     |       | C 51 SW SE   |
| TP.    |       |     |       |              |
| H.     | 3508  |     |       |              |
| Tr.    |       |     |       |              |
| Dg.    |       |     |       |              |
| BL.    |       |     |       |              |
| L.     | 3543  |     | 12.52 | Geol.        |
| K.C.   |       |     |       | Contr.       |
| B.K.C. |       |     |       | Co. tools    |
| Ce.    |       |     |       |              |
| C.     |       |     |       | Pool         |
| M.     |       |     |       | Diebolt      |
| M.     |       |     |       |              |
| K.     |       |     |       |              |
| Mz.    |       |     |       |              |
| Ma.    |       |     |       |              |
| V.     |       |     |       |              |
| S.     |       |     |       |              |
| S.     |       |     |       |              |
| A.     |       |     |       |              |
| R.     |       |     |       |              |
| Pe.    |       |     |       |              |
| G.     |       |     |       |              |
| T.D.   | 3770  |     |       |              |

ABANDONED

Date Comm.

1-8-56

APR 25 1956

8" @ 193

drls. 1800

APR 18 '56

DST

3494-3503 30" rec 550' SW

BHP 1250 / DST 3572-24 1hr

rec 30' WT BHP 510 DST

3598-3623 1hr rec 5' Md BHP

DST 3626-40 2 hrs rec 450'

SW BHP 725 / 3742 APR 25 '56

DST 3696-3770 30" rec 5' Md

BHP 35 D E' Q