

Section 5 Township 11 Range 17 W

Well No. # 1 Madden

Company Musgrove Pet.

NORTH

				0			

WEST

EAST

SOUTH

7

Sec. 5 Twp. 11 R. 17W

Well No. #1 Madden Farm

Musgrove Pet. Company

Musgrove Contractor

Burnett Pool

Ft. from N. Line


330

Ft. from S. Line

Ft. from E. Line

330

Ft. from W. Line

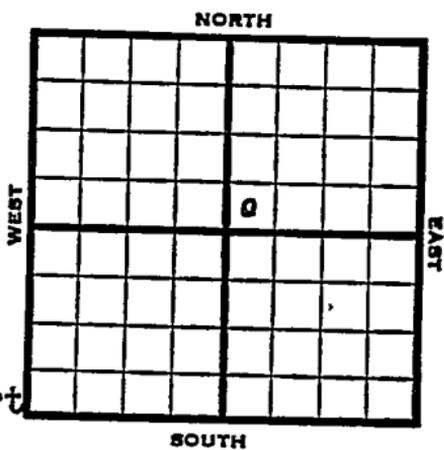

SWSW NE

NCRA & Stanol. support

1953 Elev 1991' REPORT

6/24 Spud 6-19-53

8" @ 137'

Drlg 1230'

7/1 Heeb 3167, Lans 3209

Drlg. 3246'

7/8 Spud 6-19-53

D & A

TD 3604'

8" @ 137'

Heeb 3167', Lans 3209', Cong 3478,

Simp 3535, Arb 3562

TD 3604'

D & A

ABANDONED

