


Ellis

Section 5 Township 11 Range 18-W

Well No. #1 Richards

Company C. B. Davis

NORTH Richards Pool

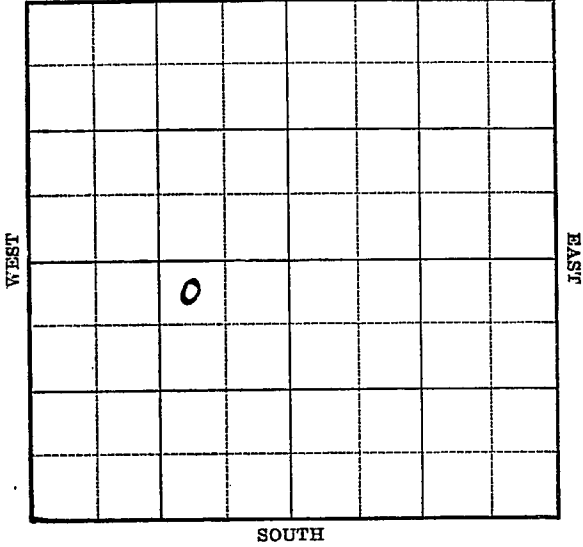

KANSAS

Ellis

Sec. 5 Twp. 11 R. 18-W

Well No. #1 Richards Farm

C. B. Davis Company

(Richards)


330 Ft. from N. Line

_____ Ft. from S. Line

990 Ft. from E. Line

_____ Ft. from W. Line

Elev. 2065

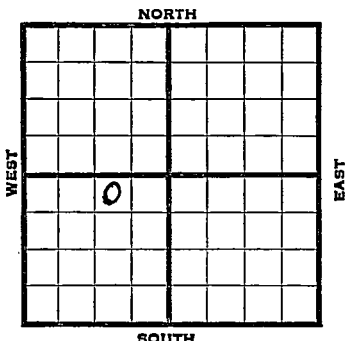

1939	REPORT
1/18	B.R.R.
1/27	10" - 148'. Anhy 1393'.
	Drig. 1435.
2/3	Topeka 2050'. Lans. 3300'.
	Drig. 3329'.
2/8	S. O. 3530-33'.
	Cong. 3538'.
	Simp. 3645'.
	Arb. 3666'.
	T. D. 3673'.
	Show dead oil.
	ABANDONED

Map No. _____ Sec. 5 Twp. 11 R. 18W

Well No. 1 Richards

C. B. Davis Company

Contractor

Cities Ser. F.O.

FIRST REPORT

SECTION PLAT

NW NE SW

	0		

330 Ft. from N. Line

_____ Ft. from S. Line

990 Ft. from E. Line

_____ Ft. from W. Line

RICHARDS POOL

RECORD

Location _____

Cased _____ in., _____ ft.

Rig up _____

Sand _____

Drilling and Remarks:

Gas _____

BRR

Oil _____

Total Depth _____

PRODUCTION

1st 24 hrs. Nat. _____

1st 24 hrs. after shot _____

Gas _____ Cu. Ft.

Dry Hole _____

Abandoned _____

Date

JAN 18 1939

19

H. D. Hatfield

Scout

Map No. _____ Sec. 5 Twp. 11 R. 18W

Well No. 1 Richards

C. B. Davis Company

Contractor

ABANDONED
NW NE SW

330 Ft. from N. Line

_____ Ft. from S. Line

990 Ft. from E. Line

_____ Ft. from W. Line

SECTION PLAT

	0		

RICHARDS POOL

Location _____

Rig up _____

Drilling and Remarks:

S.O. 3530-33
cong. 3538
simp 3645
Arb 3666
T.D. 3673
show dead oil

DYA

RECORD

Cased _____ in., _____ ft.

Sand _____

Gas _____

Oil _____

Total Depth _____

PRODUCTION

1st 24 hrs. Nat. _____

1st 24 hrs. after shot _____

Gas _____ Cu. Ft.

Dry Hole _____

Abandoned _____

Date

FEB 8 1920 19

H. D. H.

Scout

Prof. Paul