

Ellis


FORM 51 5M 2-38 TPCO.

KANSAS

Section 5 Township 11 Range 18-W

Well No. 1 Richards Ranch

Company C. B. Davis & Glimac

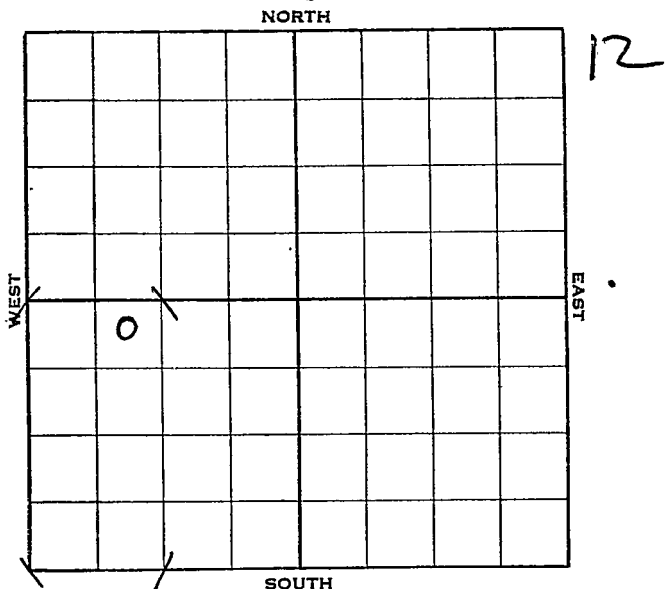

KANSAS

Ellis


Sec. 5 Twp. 11 R. 18-WWell No. #1 Richards Ranch FarmC. B. Davis & Glimac Company330 Ft. from N. Line

Ft. from S. Line

Ft. from E. Line

990 Ft. from W. Line

Elev. 2054

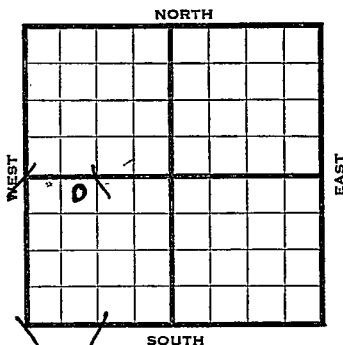

1938	REPORT
8/17	R. R.
8/26	"
9/2	R U R
9/9	12" - 167'. WOC.
9/16	Anhy 1395'. Dlg. 2105'.
9/23	Topeka 3098'. Dlg. 3104'.
9/30	Lans. 3295'. S. O. 3318-25'.
	7" - 3317'. Drlg. 3336' No oil.
10/7	H.F.W. 3342-49'.
	Oil Pay 3379-81'. 7 bailer oil thru 1800' wtr.
	Pay 3394-97' T.D. 2400' Water. C. O.
10/14	Shut down.
10/21	Dlg. 3430'.
10/28	S. S. O. 3476-80' T. D.
	S.D. for 5" casing.
11/4	B. K. C. 3485'. T. D. 3516'.
	S. D. Repairs.
11/12	5" - 3544'. Cherty cong. 3565'.
	T. D. 3569'. U. R. 5".

OVER

1938

11/18 5" - 3616'. Dlg. 3625'.

11/25 T. D. 3657'. No Arbuckle
Will P. B.

12/2 P. B. 3400'. 7000 acid.
No Oil . S. D. O.

12/7 7" - 3317'.

5" - 3616'.

Lans. 3295'.

Cong. 3565'.

No Arb. ~~3657'~~

T. D. 3657'.

P. B. to 3400'.

7000 acid.

Potential 115 bbls. Show of wt.

COMPLETED

Map No. 71 Sec. 5 Twp. 11 R. 18WWell No. 1 Richards RanchC. B. Davis & Glimac

Company


Contractor

FIRST REPORT

NE NW SW

330 Ft. from N. Line Ft. from S. Line Ft. from E. Line990 Ft. from W. Line

SECTION PLAT

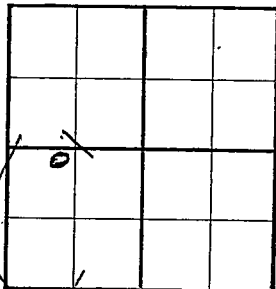Location Rig up

Drilling and Remarks:

RR

RECORD

Cased in., ft.Sand Gas Oil Total Depth

PRODUCTION

1st 24 hrs. Nat. 1st 24 hrs. after shot Gas Cu. Ft.Dry Hole Abandoned

Date

AUG 17 1938 19

H. D. Hatfield

Scout

Ray

[Handwritten signature]

Returned	<i>Ray</i>
Cards	<i>Ray</i>
Tracing	<i>Ray</i>
France Map	<i>Ray</i>
Scarborough Map	<i>Ray</i>
Moody Map	<i>Ray</i>
Scarborough Plat Book	
Moody Plat Book	

Ellis KANSAS

Map No. _____ Sec. 5 Twp. 11 R. 18WWell No. 1 Richards RanchC. B. Davis & Glimac Company

Contractor

COMPLETED

NE NW SW

330 Ft. from N. Line

_____ Ft. from S. Line

_____ Ft. from E. Line

990 Ft. from W. Line**SECTION PLAT**

0			

Location _____

Rig up _____

Drilling and Remarks:

P.B. 34007000 AcidPot 115S.W.**RECORD**Cased 7 1/2 in., 3317 ft.Sand LANS 3295Gas CONG 3565Oil NO ArbTotal Depth 3657**PRODUCTION**

1st 24 hrs. Nat. _____

1st 24 hrs. after shot _____

Gas _____ Cu. Ft.

Dry Hole _____

Abandoned _____

Date

DEC 7 - 1938 19H. D. Hatfield Scout

Misc. Small Items

Cards

Trace of

File

File

File

File

File

File