


Section 5 Township 11 Range 20W

Well No. #1 Fischer

Company Francis Oil & Gas

NORTH

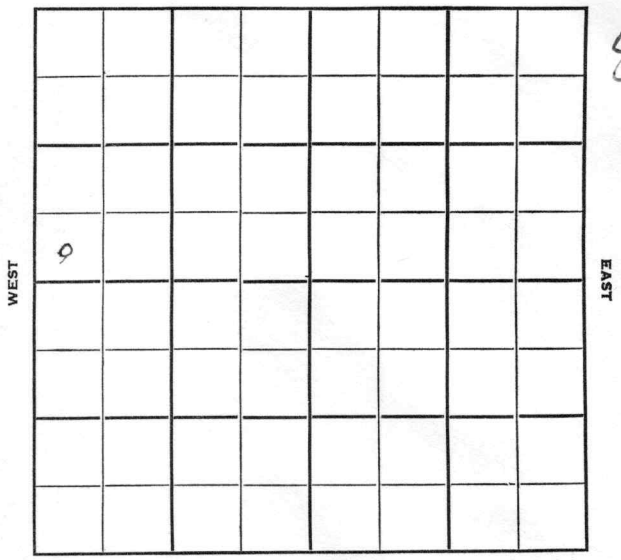

SOUTH

Ellis

KANSAS

Sec. 5 Twp. 11 R. 20 W

Well No. # 1 Fischer Farm

Francis Oil & Gas Company

Veeder Contractor

Wildcat


_____ Ft. from N. Line

330 Ft. from S. Line

_____ Ft. from E. Line

330 Ft. from W. Line

SW SW NW

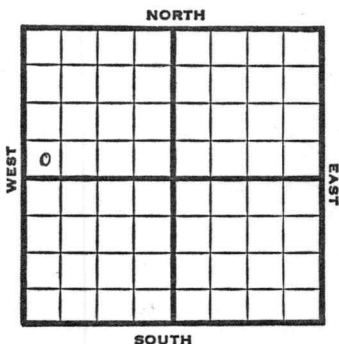

1951

Elev. 2062'

REPORT

10/10 Cellar & Pits

11/21 Spud 10-9-51

Oil well TD 3684' 8" @ 268

Anhy 1512' Heeb 3318' Lans. 3352'

DST 3484-3530 open 1 hr. rec 6' mud

Marm. 3535' Cong. 3627' Simp. 3655'

Arb. 3665'

DST 3666-70' open 20 min. rec 33' mud

DST 3666-82 open 1 hr. rec 10' free oil, 60' HOCM

TD 3682' 5" @ 3680 DD 3684'

1000 A S/2 BOPH 24/3668-72

1000 A S/5 1/4 BOPH

Comp. 120 BOPD

COMPLETED

County Ellis State Kansas

Sec. 5 (Blk. Twp.) 11 (Sur. Rge.) 20W Map No.

Operator Francis Oil & Gas

Well No. 1 Farm Fischer

Elev. 2062 Location SW SW NW

330 Ft. From S Line NW

330 Ft. From W Line Quarter

1st. Report

Completion NOV 21 1951

Remarks Wildcat

Veeder - Contr.

Spudding Date 10-9-51

Drig. Data Oil well TD 3684

8" @ 268 Anhy 1512 Heeb. 3318

Lans. 3352 DST 3484-3530 open 1 hr.

Rec. 6' mud Marm. 3535 Cong. 3627

Simp. 3655 Arb. 3665 DST 3666-70

open 20 min. Rec. 33' mud DST 3666-82

open 1 hr. Rec. 10' free oil 60' hocm

TD 3682 5" @ 3680 DD 3684 1000 A

S/ 2 boph 24/ 3668-72 1000 A

S/ 5 $\frac{1}{4}$ boph Comp. 120 bopd