


Ellis

KANSAS

SECTION 5 TOWNSHIP 11 RANGE 20W

WELL NO. #1 Fisher

COMPANY Fred Nixon & Bear

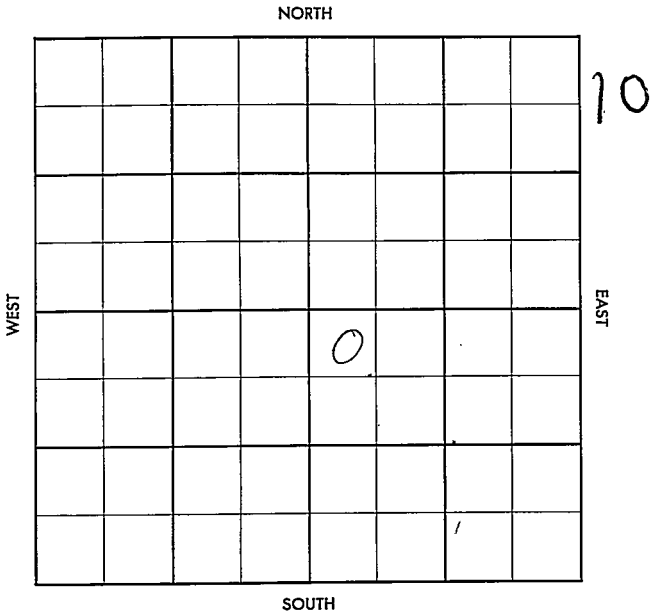

WILDCAT

FORM 513 SUNRAY

County Elvis Elev. _____
 Sec. 5 Twp. 11 Rge. 20W
 Company Fred Nixon & Bear
 Farm Name Fisher No. 1

TOPS	DEPTH	LOG	DATUM	Loc. in Sec.						
Anh.				NW NW SE						
Tr.										
H.										
Tr.										
Dg.										
Bl.										
L.				Geol. _____						
K.C.				Contr. _____						
B.K.C.				Veeder Supply						
Ce.				Pool						
C.				Wildcat						
M.				<table border="1"> <tr> <td colspan="2">FIRST REPORT</td> </tr> <tr> <td></td> <td>9</td> </tr> <tr> <td>DEC 12 '56</td> <td></td> </tr> </table>	FIRST REPORT			9	DEC 12 '56	
FIRST REPORT										
	9									
DEC 12 '56										
M.										
K.										
Mz.										
Ma.										
V.										
S.										
S.										
A.										
R.										
Pe.										
G.										
T.D.										

Date Comm. 12-8-56
8" @ 229/140 d rlg. 2500

(Handwritten scribble)

Co.
L.S.
T.
R.

County ELLIS Elev. 2078
 Sec. 5 Twp. 11 Rge. 20W
 Company Fred Nixon & Bear
 Farm Name Fisher No. 1

TOPS.	DEPTH	LOG	DATUM	Loc. in Sec.
Ank.				NW NW SE
Ip.				
H.	3329			
Tr.	3350			
Dg.				
Bl.				
L.	3367			Geol.
K.C.				Contr.
B.K.C.	3598			Veeder Supply
Ce. <i>Marin</i>	3608			Pool
C. <i>cherty</i>	3625			Wildcat
M.				<div style="border: 1px solid black; padding: 5px; text-align: center;"> ABANDONED DEC 20 '56 </div>
M.				
K.				
Mr.				
Mo.				
V.	3656			
S.				
S.				
A.	3669			
R.				
PE.				
G.				
TD.	3694			

Date Comm. 12-8-56

8" @ 229/110 d rlg. 2500 DEC 19 '56

DST 3670 - 78 up 1 hr 12' p. Md
 (550) BHP 780 / 20" DST 3677
 - 94 1 hr 95' WM BHP 1100

DEU