

DRILLING WELL COMPLETION REPORT

Well No. 1 Farm Name H. A. Wacker #1
Date completed Sept. 29, 1947
Description SU/4 Section 5-115-207
Initial production 200 bbls. Total depth 2600 feet
Initial volume _____ cu. ft. _____ lbs. rock pressure
Pipe Line Company _____
Gas Company _____
Remarks: SDPC 50%
Barnett Drilling Co. 50%

A. W. Bixler

W


Mr. Koontz
Accounting Dept.
Scouting Dept.
Geological Dept.
Pipe Line Dept.
Materials Dept.
Inventory Comptroller
Rental Dept.
Legal Dept.
Tax Dept.
Engineering Dept.
Lease Inventory
File

LOCATION NOTICE

TULSA, OKLA., September 9, 1947

WELL NO. 1 ON H. A. Fischer "A" FARM

WILL BE AS FOLLOWS:

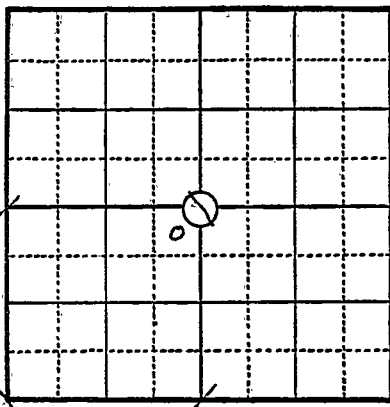

330 FEET FROM NORTH LINE
330 FEET FROM EAST LINE
 FEET FROM SOUTH LINE
 FEET FROM WEST LINE

IN SW/4 SEC. 5 TWP. 11S RANGE 20W
Ellis COUNTY, STATE OF Kansas

REMARKS: Lloyd Snyder, Dist. Supt.
A. E. Johnson, Dist. Foreman
M. G. P. C. — 50%
Barnett Drilling Co. — 50%

SIGNED A. E. Pierce

COPIES TO

- MR. KOONTZ
- DISTRICT SUPT.
- ACCOUNTING DEPT.
- SCOUTING DEPT.
- GEOLOGICAL DEPT.
- PIPE LINE DEPT.
- MATERIALS DEPT.
- RENTAL DEPT.
- LEGAL DEPT.
- TAX DEPT.
- ENGINEERING DEPT.
- LEASE INVENTORY
- CLAIM DEPT.
- FILE

W
Card
B.B.
[Signature]