

KANSAS


FORM 51 5M PETROL

Trego

Section 5 Township 11 Range 25W

Well No. #1 Walsh

Company Lion Oil Ref. & Auto Ord.

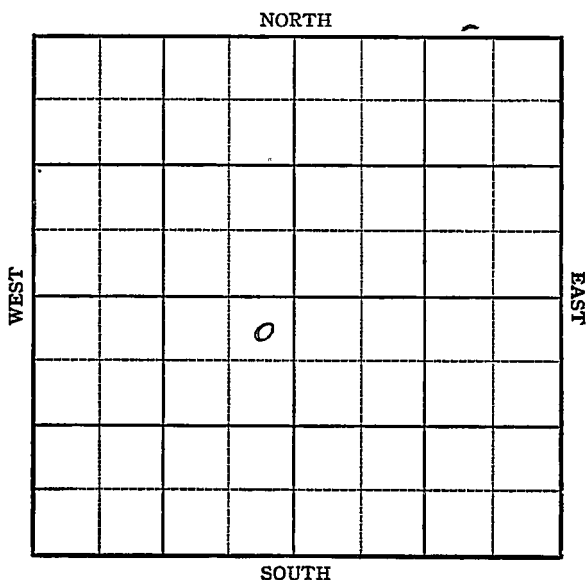

KANSAS

Trego

Sec. 5 Twp. 11 R. 25-W

Well No. #1 Walsh Farm

Lion Oil Refg. & Auto Ord. Company


NE SW

330 Ft. from N. Line

 Ft. from S. Line

330 Ft. from E. Line

 Ft. from W. Line

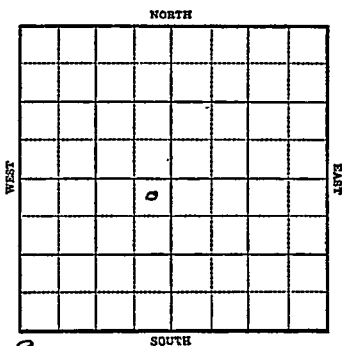

Elev. 2429

1944

R E P O R T

1-26

Derrick

2/2

8" @ 292
Drlg. 300'

2/8

" "

2/16

Lans 3680
Miss 4330
Viola 4513
TD 4621
No shows.

ABANDONED

KANSAS


Map No. 68 Sec. 5 Twp. 11 R. 25WWell No. 1 WalshLion Oil Ref. & Auto Ord. Company

FIRST REPORT

Contractor

NE SW

SECTION PLAT

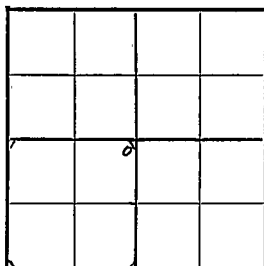330 Ft. from N. Line Ft. from S. Line330 Ft. from E. Line Ft. from W. LineWildcatLocation Rig up

Drilling and Remarks:

Derrick

RECORD

Cased in., ft.Sand Gas Oil Total Depth

PRODUCTION

1st 24 hrs. Nat. 1st 24 hrs. after shot Gas Cu. Ft.Dry Hole Abandoned

Date

JAN 26 1911 19S. J. LEWIS Scout

Trego

Map No. KANSAS 68 Sec. 5 Twp. 11 R. 25W
 Well No. 1 Walsh

L ion Oil Ref. & Auto Ord.
 Company

ABANDONED

Contractor

NE SW

SECTION PLAT

330


Ft. from N. Line

Ft. from S. Line

330

Ft. from E. Line

Ft. from W. Line

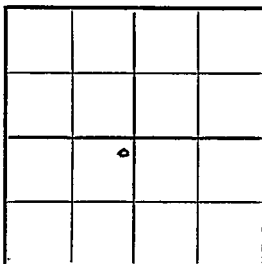

Wild cat

Location

Rig up

Drilling and Remarks:

*Liams 3680**Miss 4830**Vivian 4463**Or X 4513**No show*

RECORD

Cased _____ in., _____ ft.

Sand _____

Gas _____

Oil _____

Total Depth 4621

PRODUCTION

1st 24 hrs. Nat. _____

1st 24 hrs. after shot _____

Gas _____ Cu. Ft.

Dry Hole _____

Abandoned _____

Date

FEB 16 1911 19

S. J. LEWIS Scout